


SUMMARY REPORT  
FOR PACIFIC AIR PRODUCTS COMPANY  
SOLIDHD MOUNTING PLATES  
GRAND GULF NUCLEAR POWER STATION  
UNITS 1 & 2

B204020310 B263.11  
PDR ADDCK 05000416  
A PDR

SUMMARY REPORT FOR PACIFIC AIR PRODUCTS COMPANY

SOLENOID MOUNTING PLATES

GRAND GULF NUCLEAR POWER STATION-UNITS #1 AND #2

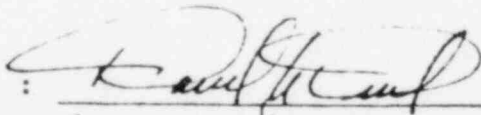Prepared by :  Date: 3/10/82  
Independent Review by: Stephen A. Descoteaux Date: 3/10/82  
Approved by : Richard E. Green Date: 3/10/82

INTERNATIONAL ENERGY ENGINEERING, INC.  
77 North Washington Street  
Boston, Massachusetts 02114

Revision 0  
March 10, 1982

SUMMARY REPORT FOR PACIFIC AIR PRODUCTS COMPANY

SOLENOID MOUNTING PLATES

TABLE OF CONTENTS

<u>SECTION</u>		<u>PAGE</u>
1.0	Certification	1
2.0	Introduction	2
3.0	Description	3
4.0	Design Criteria	5
5.0	Loading Conditions	7
6.0	Mathematical Model	8
7.0	Computer Programs	12
8.0	Analysis Techniques/Results	13
9.0	Summary of the Analysis	18
10.0	Sources of Formulae and References	19
Appendix A	Calculations	
Appendix B	Computer Output	Volumes 1-6

Revision 0  
March 10, 1982

1.0 CERTIFICATION

This report was prepared for Bechtel Power Corporation by International Energy Engineering in accordance with Specification 9645-M-617.1. The report is part of the seismic qualification of the Pacific Air Products Company automatic damper solenoid mounting plates for the Grand Gulf Nuclear Power Station, Units 1 and 2.



Certified by:

Richard E. Green

Richard E. Green, Professional Engineer

Maine No. 4104

Revision 0  
March 10, 1982

## 2.0 INTRODUCTION

This report is in response to NRC inquiries concerning the solenoid valve mounting plates supplied by Pacific Air Products Company under Bechtel's Grand Gulf Specification 9645-M-617.1. These plates are associated with the automatic dampers having the following MPL numbers:

Q1Z77F001A	Q2Z77F001A
Q1Z77F001B	Q2Z77F001B
Q1Z77F002A	Q2Z77F002A
Q1Z77F002B	Q2Z77F002B
Q1Z77F003A	Q2Z77F003A
Q1Z77F003B	Q2Z77F003B
Q1Z77F035A	Q2Z77F035A
Q1Z77F035B	Q2Z77F035B

During its Seismic Qualification Review Team (SQRT) walk-down, the NRC indicated that, "An unacceptable mounting of the solenoid valve was noted during the field inspection. The valve was mounted on a rather flexible mounting plate such that impacting could occur between the plate and a heavy air cylinder behind it . . . Impact loading could result in seismic loads well in excess of that for which the equipment is qualified."

Bechtel agreed to eliminate the impacting situation by modifying the mounting plate. International Energy Engineering (IEE) was retained to design and analyze the modifications, thereby eliminating the potential impacting.

Revision 0  
March 10, 1982

### 3.0 DESCRIPTION

There are sixteen mounting plates, supplied by Pacific Air Products Company, located at Elevation 111'-0" and Elevation 133'-0" of the Grand Gulf Control Building.

The plates are 15" x 20.5" x 10 gage sheet steel, weighing approximately 12.0 pounds. Supported on this plate are a solenoid valve weighing approximately 3.0 pounds, supplied by ASCO; two limit switches weighing approximately 4.5 pounds each, supplied by NAMCO, and a Sun junction box weighing approximately 9.5 pounds. The valve, limit switches, and junction box are attached to the mounting plate through use of metal fasteners.

The mounting plate is bolted directly into the hub of the heavy air cylinder which is located behind the plate. In addition, restraint has been provided in the vicinity of the junction box through use of structural members.

Although the mounting and support arrangements vary from plate to plate, the general configuration of the units is illustrated by Figure 1.

Revision 0  
March 10, 1982

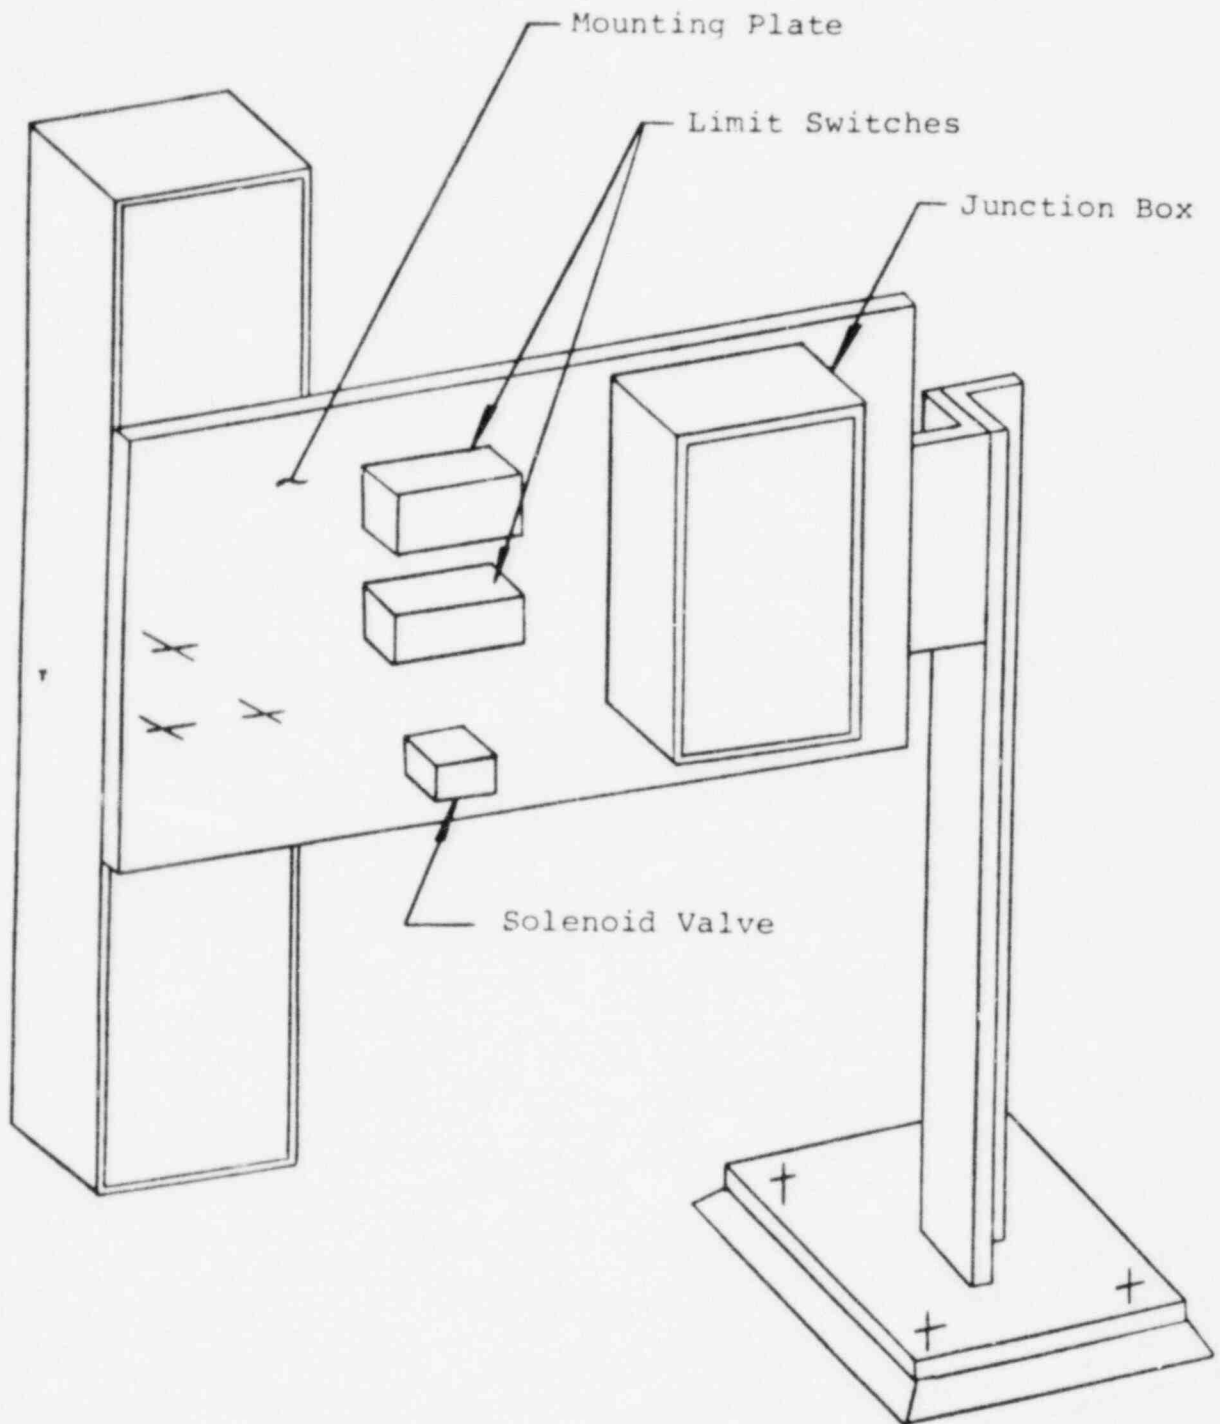


Figure 1 - General Configuration, Solenoid Valve Mounting Plate

Revision 0  
March 10, 1932

## 4.0 DESIGN CRITERIA

### 4.1 Deflection

For this analysis, deflection was limited to 0.0625 inches (1/16"). Field inspections indicated that 1/16" of clearance would be necessary to ensure that no impacting could occur between the mounting plate and the heavy air cylinder behind it.

### 4.2 Stress

Evaluation of structural steel members and plates was in accordance with the AISC Specification, Seventh Edition. However, no increase in allowable stresses was used for earthquake loading. A value of 36 ksi was used as the yield stress for all structural steel.

Allowable weld stress for fillet welds was taken as 0.30 times the yield stress of the base metal. Bolts equal to or greater than 1/2 inch in diameter were evaluated in accordance with the AISC Specification, Seventh Edition. Smaller bolts utilize the same procedure except that allowable stresses were taken from Marks Handbook, Eight Edition. Bechtel Specification 9645-C-103.1, Rev. 8 was used for the design of Hilti anchor bolts.

### 4.3 Seismic

Seismic criteria was dictated by Section 6.10.2 of Bechtel Specification 9645-M-617.1, which notes that seismic qualification may be in accordance

Revision 0  
March 10, 1982



with Appendix S (Bechtel Specification 9645-C-196.0).  
Seismic qualification conformed to Sections 4.1.1,2  
of Specification 9645-C-196.0.

For rigid equipment (natural frequency  $>$  33 cps),  
the equipment was analyzed statically, and the seismic  
forces on equipment components were obtained by mul-  
tiplying the mass and the appropriate acceleration.

For flexible equipment (natural frequency  $<$  33 cps),  
the equipment was analyzed dynamically by using  
the response spectra modal analysis technique.

Revision 0  
March 10, 1982

5.0 LOADING CONDITIONS

For the analysis, the mounting plates were simultaneously subjected to two types of loads:

- 1.) Deadweight
- 2.) Maximum seismic loads in three directions were taken from the Safe Shutdown Earthquake (SSE) response spectra curves for the Control Building at Elevation 133'-0".

For rigid plates, the loads were based upon acceleration values corresponding to Zero Period Acceleration. For flexible plates, the loads were based upon acceleration values determined in accordance with the response spectra modal analysis technique.

Maximum stresses and deflections for the worst loading cases were determined by combining deadweight and seismic loads.

Revision 0  
March 10, 1982

## 6.0 MATHEMATICAL MODEL

The typical actuator damper solenoid configuration consists of a 15" x 20.5" x 10 gage sheet steel plate upon which is mounted a solenoid valve, two limit switches, and a junction box. The mounting plate is attached to a support structure which generally is located at the junction box end of the plate, and then extends to an existing HVAC duct support or to the floor. Since the support structures must be removable, a two-bolt (1/2" diameter A307 bolts) connection is provided at adjoining plate sections and/or angle sections for each structure. In addition, the solenoid plate is bolted to a heavy air cylinder with (3) 1/2" diameter bolts.

The solenoid plate is represented by quadrilateral plate finite elements. The node and element numbers are consistent for all (16) problems. The node points corresponding to the locations of the three anchor bolts connecting the solenoid plate to the heavy air cylinder are considered fixed restraints (three translations and three rotations are fixed); this reflects the clamping action of the bolts.

The internal components of the solenoid valve, limit switches, and junction box are not included in this analysis. The mass and mass moments of inertia for each of these items are lumped at their centers of gravity and are connected to the solenoid plate by rigid elements at their bolted locations.

In general, the bracing supports for the solenoid plates are characterized by a structural element which is 1) welded to the junction box edge of the plates, and 2) bolted to adjoining plate sections. The structural element is either a plate or an angle section. The bolted

Revision 0

March 10, 1982

connection is through the outstanding legs of back to back angles or through a plate section and the outstanding leg of an angle section. Since the typical bolted connection consists of (2) bolts, the moment about the axis described by the line of bolts was considered free between the interconnecting elements. Therefore, three forces and two moments were transferred between interconnecting elements at the bolted locations.

The point of connection of the bracing support structure to the HVAC duct support member or to the floor was considered a fixed anchor point for analysis purposes. However, stiffener bars have been inserted on the HVAC duct support members at the point of connection with the solenoid plate support.


Three methods were used to model the stiffening effects of the structural elements welded to the solenoid plate. These methods are shown in Figure 2 as Case A, Case B, and Case C. The elements are schematically shown as plate sections but are meant to encompass both plate sections and/or legs of angles.

Most of the analyses employed the structural model shown in Case A of Figure 2. For this method, the stiffness properties of the structural element are transferred to one location on the solenoid plate (Point 1) through an offset member at the edge of the plate. The effects of the structural element overlapping the solenoid plate are accounted for by increasing the thickness of the existing quadrilateral plate elements located at the overlapped area.

Cases B and C of Figure 2 are progressively more refined modeling techniques that would produce a more accurate

Revision 0  
March 10, 1982


Structural Element  
(Typical)

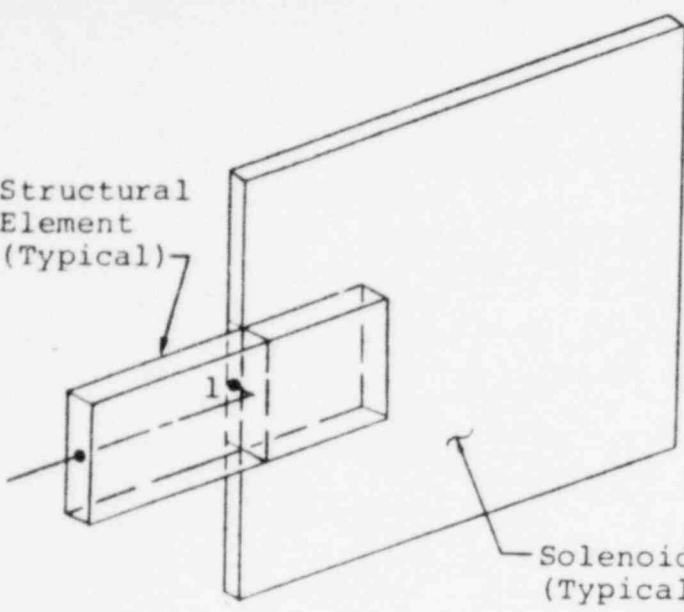


Case A - Computer Generated  
Rigid Element Offset

Solenoid Plate  
(Typical)

r

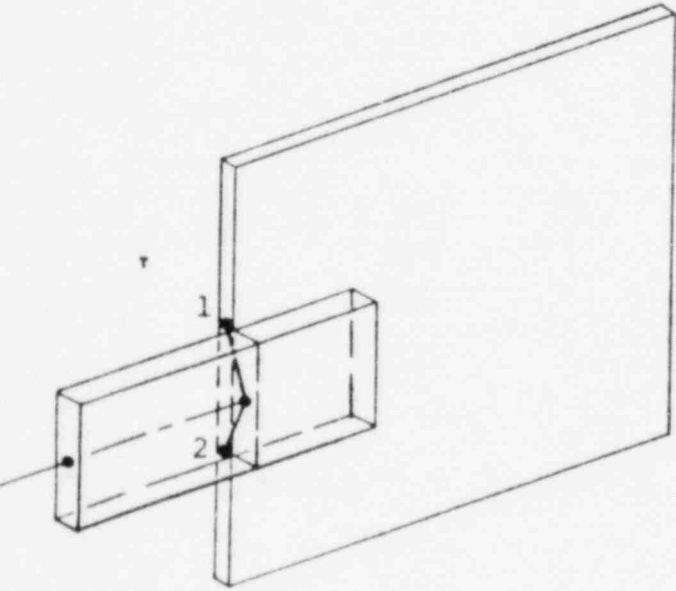

Case B - TS 4 x 4 x 1/4 Offset

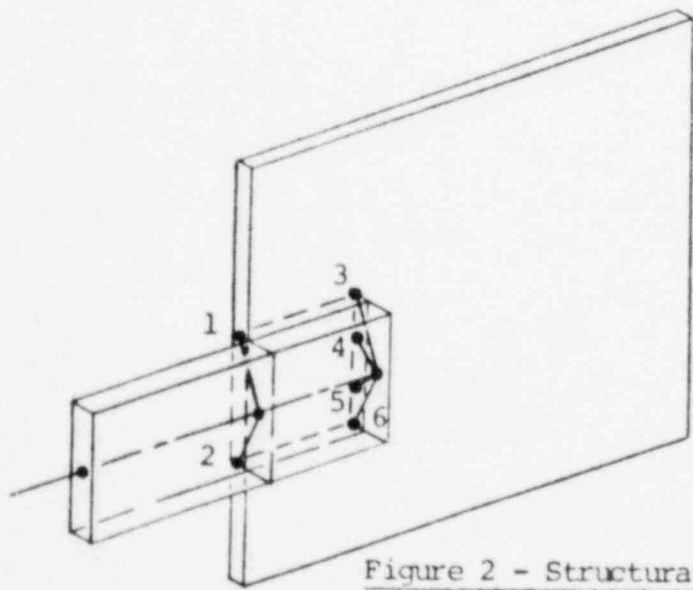

Case C - TS 4 x 4 x 1/4 Offset

Figure 2 - Structural Element To Solenoid Plate Connections

Revision 0

March 10, 1982

representation of the structural element connected to the plate. Case B was used for the analysis of FCN-1137. Case C was used for the analyses of FCN-1143 and FCN-1148.

For Case B, the stiffness properties of the structural element are transferred to two points on the solenoid plates by means of offset members. These offset members extend from the centerline of the structural plate to the top and bottom node points on the solenoid plate. Again, the effects of the overlapping portion of the structural plate on the solenoid plate are accounted for by increasing the thickness of the existing quadrilateral plate elements.

For Case C, the entire structural plate is modeled onto the solenoid plate. Two sets of offset members are used, at the connection between the structural plate and the solenoid plate. Multiple offset members from the centerline of the structural plate to the node points on the solenoid plate are used to represent a full line of weld. In this case, the thickness of quadrilateral plate elements is not increased.

The offset member shown in Case A is generated by the computer as a rigid element. The offset members shown in Cases B and C are modeled as TS 4 x 4 x 1/4 members. This causes the offset to be semi-rigid such that increased bending effects become negligible.

The remaining structural members of the support structure are modeled as beam elements.

Revision 0  
March 10, 1982

7.0 COMPUTER PROGRAMS

The STARDYNE computer program (1977 update of Version 3) was used for natural frequency determination, static analysis, and response spectra modal analysis. STARDYNE is a public domain program which is readily available through Control Data Corporation (CDC).

STARDYNE was the only computer program used in this analysis.

Computer output for the analysis is enclosed as Appendix B.

Revision 0  
March 10, 1982

## 8.0 ANALYSIS TECHNIQUES/RESULTS

This section describes the procedures used to analyze the mathematical models of the solenoid plate structures. Critical assumptions for this analysis have also been provided. The calculations for the analysis are enclosed with the report as Appendix A.

### 8.1 Procedure

The intent of this analysis was to demonstrate that during a seismic event, the solenoid mounting plates would not impact against the nearby air actuators and be subjected to unanticipated dynamic loads. To accomplish this, it was necessary to show that the maximum seismic deflection of the solenoid plate would be less than 1/16".

Before beginning the analysis, four sets of Control Building response spectra were reviewed: SSE at Elevation 133'-0" with 3% damping, SSE at Elevation 111'-0" with 3% damping, 1/2 SSE at Elevation 133'-0" with 2% damping, and 1/2 SSE at Elevation 111'-0" with 2% damping. The curves for Elevation 133'-0" with 3% damping conservatively were used because these curves provide the largest accelerations. Seismic loads were applied to the solenoid plate structures by imparting appropriate acceleration values in three directions.

Revision 0  
March 10, 1982



The Zero Period Acceleration (ZPA) for all curves is assumed as 33 cps. By ensuring that the lowest system natural frequency is above the ZPA of the SSE response spectra, a static analysis is justified for structural evaluation. For this analysis, 0.223g vertical and 0.323g horizontal can be applied to the structure if the lowest system natural frequency exceeds 33 cycles per second. The 0.323g value is an envelope of N-S and E-W ZPA accelerations. Fifteen of the sixteen solenoid plate problems are included in the category of static analysis.

The Lanczos modal extraction program indicated that for solenoid plate problem FCN-M-1143, the lowest system natural frequency was less than 33 cycles per second. In this case, the structural model is considered flexible and is analyzed by the response spectra modal analysis technique. Since the lowest system natural frequency of 24.7 cycles per second is the only natural frequency below the ZPA, the structure is relatively rigid with little variation in acceleration values over the range of natural frequencies. Accordingly, the first (6) natural frequencies of the structural model were used in the modal analysis program (DYNRE 4). These cover a frequency range of 24.7 to 172.9 cycles per second and are considered a sufficient number of significant modes. The response of interest, i.e., deflection, accelerations, loads, and stresses, are determined by taking the square root of the sum of the squares (SRSS) of each modal response. The SRSS also is used in combining the effects of the two

Revision 0  
March 10, 1982

horizontal and vertical directions. Provisions are made in this analysis for including the effects of closely spaced modes for which consecutive frequencies differ by 10% or less. This is in accordance with the ten-percent method of analysis outlined in the NRC Regulatory Guide 1.92.

The static analysis for each of the (15) solenoid plate problems with a natural frequency greater than 33 cps includes the effects of dead load and seismic loading. For the FCN-M-1143 analysis, the results of a separate static dead load analysis are combined with the DYNRE 4 analysis by absolute sum to generate values used in the calculations.

In the calculations section, the following items are checked: member stresses, quadrilateral plate stresses, bolt and screw loads, weld profiles, and maximum deflections.

## 8.2 Assumptions

- The electrical components that comprise the junction box, solenoid valve, and limit switches are not included in this analysis. Qualification of these components, considering no impact between the solenoid plates and air actuator, is by others.
- A minimum of (3) bolts is considered to connect each solenoid plate to its corresponding air actuator. The nodes representing these bolts are treated as fixed restraint points at their locations in the structural model.

Revision 0  
March 10, 1982

- The point of attachment between the structural support and the solenoid plate was approximated as closely as possible to existing node points on the solenoid plate element grid.
- All offset elements between centerlines of members were modeled in two ways: as rigid elements generated by the computer, and as members with a finite stiffness provided by section properties.
- The limit switches, solenoid valve, and junction box were treated as lumped masses with rotational inertias located at their centers of gravity, and were connected by rigid elements to the solenoid plate.
- The structural elements welded to the solenoid plates are analyzed as solid rectangular beam sections; the legs of the angle sections welded to the solenoid plate are treated as solid rectangular beams.
- The bolted connection between back to back structural elements was considered to transmit (3) forces and (2) moments; the moment about the axis describing the bolt line was considered free.
- The points of attachment of the bracing structures that frame into existing HVAC duct support members were considered fully fixed.

Revision 0  
March 10, 1982

- Loadings to floor mounted base plates for the two applicable solenoid plate problems are assumed negligible.
- Weight density of structural elements =  $0.2833 \text{ lb/in}^3$
- Weight density of solenoid plate =  $0.2904 \text{ lb/in}^3$
- $E = \text{Young's Modulus} = 29,000 \text{ ksi}$
- $g = 386.4 \text{ in/sec}^2$

Revision 0  
March 10, 1982

## 9.0 SUMMARY OF THE ANALYSIS

The natural frequency for 15 of the 16 mounting plates was computed as greater than 33 cps, and static analysis, as described in Section 4.3, was used for qualification. For the sixteenth plate, Q2Z77F003B, the natural frequency was computed as less than 33 cps, and the response spectra modal analysis technique was used for qualification.

As previously noted, deadweight and seismic loads were applied simultaneously for the analysis. With the supplementary structural support, the maximum plate deflection was determined to be less than 0.0625 inches. Therefore, the potential for impact between the heavy air cylinders and solenoid mounting plates has been eliminated. Also, the resulting stresses in the mounting plates, structural support members, and connecting components were found to be within allowable limits.

Revision 0  
March 10, 1982

10.0 SOURCES OF FORMULAE AND REFERENCE

- 10.1 AISC Manual - 7th Edition
- 10.2 Bechtel Specification Nos. 9645-M-617.1, Rev. 7  
(including Appendix T)  
9645-C-196.0, Rev. 1  
9645-J-820.0, Rev. 1
- 10.3 Beer & Johnson, Statics & Dynamics
- 10.4 Biggs, Structural Dynamics
- 10.5 Blodgett, Design of Welded Structures
- 10.6 IEEE Standard 344-1975
- 10.7 Marks' Standard Handbook for Mechanical Engineers -  
Eighth Edition
- 10.8 STARDYNE Manual
- 10.9 Correspondence
  - Bechtel letter to Mr. T. H. Cloninger, dated  
November 30, 1981
  - Bechtel letter to Mr. R. E. Green, dated  
December 24, 1981
  - IEE letter to Mr. R. S. Trickovic, dated  
December 31, 1981
  - Bechtel letter to Mr. R. E. Green, dated  
February 11, 1982

Revision 0  
March 10, 1982

10.10 Pacific Air Products Co. Drawings:

- Document No. 9645-M-617.1-QS-1.1-3-3
- Document No. 9645-M-617.1-QS-1.1-6-4

10.11 NRC Regulatory Guides

- R. G. 1.61, "Damping Values for Seismic Design of Nuclear Power Plants"
- R. G. 1.92, "Combining Modal Response and Spatial Components in Seismic Response Analysis"

Revision 0  
March 10, 1982

APPENDIX A  
SOLUTIONS FOR  
SOLENOID MOUNTING  
PLATES  
GRAND GULF NUCLEAR POWER STATION





QUALITY ASSURANCE PROGRAM  
CALCULATION COVER SHEET

Calc. No. Q1277, Q2277

Job No. 9645

DISCIPLINE: MECHANICAL ENGINEERING

No. of sheets 95

TITLE

MISSISSIPPI POWER & LIGHT COMPANY  
GRAND GULF NUCLEAR STATION UNITS 1 AND 2

SUBJECT

PACIFIC AIR PRODUCTS COMPANY SOLENOID MOUNTING PLATES



STATEMENT OF PROBLEM

SEISMIC QUALIFICATION OF THE SOLENOID MOUNTING PLATES  
FOR THE CONTROL ROOM STANDBY FRESH AIR SYSTEM UNITS  
AT ELEVATION 133'-0" AND ELEVATION 111'-0"



SAR CHECKED

SAR CHANGE REQ'D

SAR CHANGE NOTICE INITIATED

SOURCES OF DATA

<input checked="" type="checkbox"/>
<input type="checkbox"/>
<input type="checkbox"/>

Computer Program Data - STARDYNE Version # 3

Al-2, B1-2, C1-2, D1-2, E1-2, F1-2, G1-3,  
H1-2, I1-2, J1-2, K1-2, L1-2, M1-3, N1-2,  
ATTACHMENTS: O1-2, P1-2 (INCLUDED FOR INFO. ONLY)

SOURCES OF FORMULAE & REFERENCES

<input checked="" type="checkbox"/>
<input checked="" type="checkbox"/>
<input checked="" type="checkbox"/>
<input checked="" type="checkbox"/>
<input type="checkbox"/>

Design Specification Bechtel 9645-M-617.1 Revision 7  
AISC Manual - 7th Edition  
IEEE Standard 344-1975  
For Additional Sources - See Section 10.0 of Summary Report

PRELIMINARY CALC

FINAL CALC

SUPERSEDED CALC NO. \_\_\_\_\_

REV. NO.	DATE	DESCRIPTION	CALC. BY	CHECKED BY	DATE	APPROVED BY	DATE
A	3/10/82	TO DETERMINE SEISMIC INTEGRITY	<i>[Signature]</i>	<i>[Signature]</i>	3/10/82	<i>[Signature]</i>	3/10/82



JOB NO. 9645

PROJECT MISSISSIPPI POWER & LIGHT COMPANY  
SUBJECT GRAND GULF NUCLEAR STATION

SOLENOID MOUNTING PLATE

CALCULATION SHEET


CALC. NO. 91277, 92277

REV. NO. A

BY Stephen A. Deschamps DATE 2/18/82

CHKD [Signature] DATE 3/8/82

SHEET NO. 1 OF 95

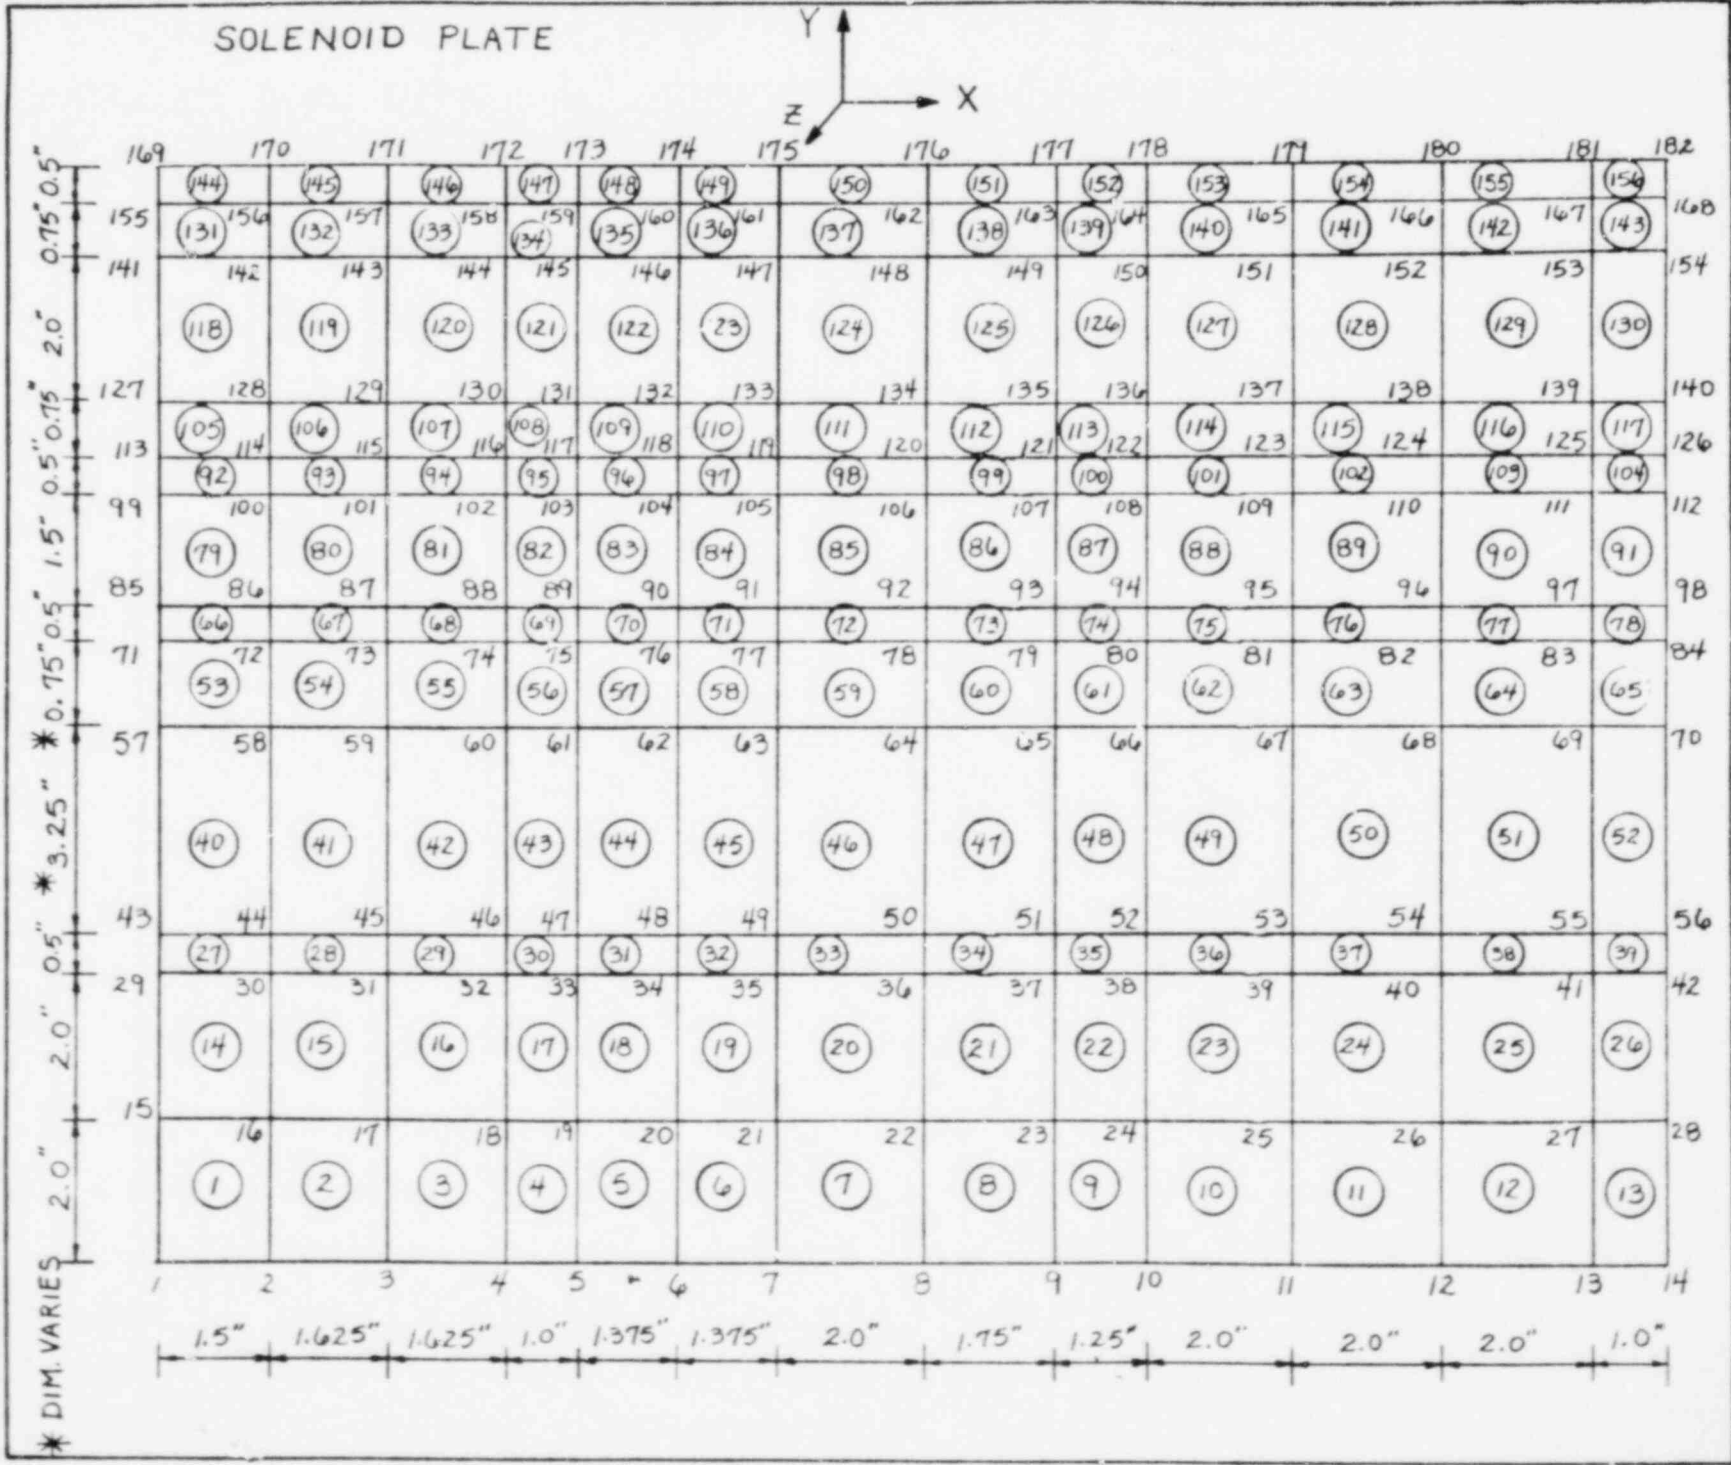



NPL # N/A

CHANGE REQUEST/NOTICE

Q  NO



JOB NO. 9648

BRN# EX-1137  
PAGE 1 OF 2

REF. DWG. OR SPEC. NO. 945-767-106-1-68 REV. 5 TITLE Safety Related Activities  
REASON FOR CHANGE/EXISTING CONDITION Control Dampers

Change Request/Sketch (if necessary)  
Add support to Hiten Solenoid mounting plate on actuator Q12776001A.

As-Built

See page 2

ATTACHMENT: A, 1 OF 2

FOR INFORMATION ONLY Date: 3/10/82



WPBR# Q12776001-C

PFE APPROVED FOR - SUBMIT TO PROJECT ENGR.   
PFE APPROVED FOR - PROCEED WITH WORK   
PFE DISAPPROVED   
PFE: R.A.B. [Signature] DATE 1/29/82

PREPARED BY: [Signature] DATE 1/29/82

ACTION BY ENGINEERING - DESCRIPTION OF CHANGE --

THIS IS: DCN # \_\_\_\_\_  
TO DWG # \_\_\_\_\_ REV. \_\_\_\_\_  
SON # \_\_\_\_\_  
TO SPEC # \_\_\_\_\_ REV. \_\_\_\_\_  
DEVIATION # D  
DATE \_\_\_\_\_  
PAGE \_\_\_\_\_ OF \_\_\_\_\_

REMARKS \_\_\_\_\_

RESP. ENGR: \_\_\_\_\_ DATE \_\_\_\_\_ CHKD: \_\_\_\_\_

GROUP SUPV. \_\_\_\_\_ DATE \_\_\_\_\_

CHIEF ENGINEER \_\_\_\_\_ DATE \_\_\_\_\_

PROJECT ENGR. APPROVAL YES  NO

SAR CHANGES YES  NO

CDT - \_\_\_\_\_ DATE \_\_\_\_\_

TO: C. D. Wood cc: L. F. Dale; C. K. McCoy; T. E. Reeves File: 0080/


SUPPLEMENTAL SHEET  
CHANGE REQUEST/NOTICE

FCN  
GRAN No. M-1137

PAGE 2 OF 2

ATTACHMENT, A, 2 OF 2

FOR INFORMATION  
ONLY Date: 3/10/82

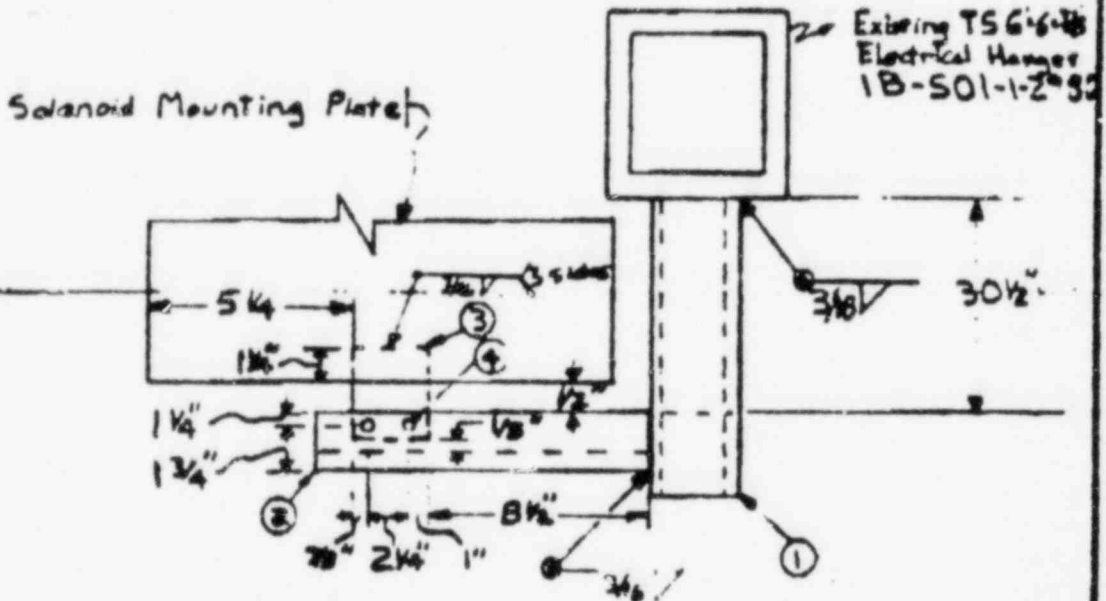

Bill of Materials

Item #	Description
1	TS 4 x 4 1/4 x 35" long
2	X 3 x 3 x 13 1/8" long
3	R 2 1/2 x 4 1/2 x 4 1/2"
4	2 - 9/16" holes for 1/2" A307 Bolts w/ Nuts



# CALCULATION SHEET

JOB NO. 9645

CALC. NO. Q1277, Q2277

REV. NO. A

PROJECT MISSISSIPPI POWER & LIGHT COMPANY

BY *[Signature]*

DATE 3/8/82

SUBJECT GRAND GULF NUCLEAR STATION



CKD Stephen A. Descoteaux

DATE 3/9/82

SOLENOID MOUNTING PLATE

SHEET NO. 2 OF 95

FCN-11-1137

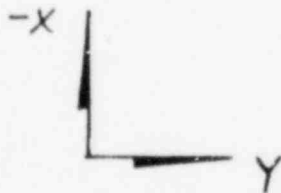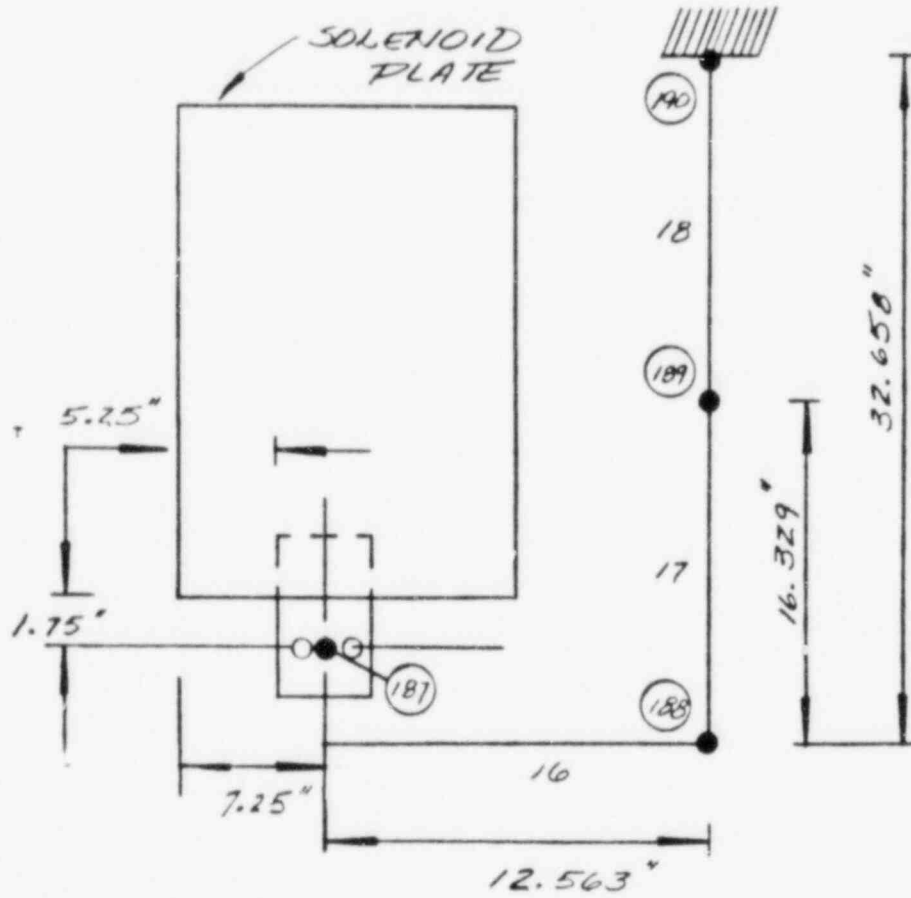

MEM

SHAPE

- 16       $\times 3" \times 3" \times 1/4"$
- 17      TS  $4" \times 4" \times 1/4"$
- 18      TS  $4" \times 4" \times 1/4"$



# CALCULATION SHEET

JOB NO. 9645

CALC NO. Q1277, Q2277 REV. NO. A

PROJECT MISSISSIPPI POWER & LIGHT COMPANY

BY [Signature] DATE 3/8/82

SUBJECT GRAND GULF NUCLEAR STATION


CKD Stephen A. Descoteaux DATE 3/9/82

SOLENOID MOUNTING PLATE

SHEET NO. 3 OF 95

FCN-M-1137

(CONT.)

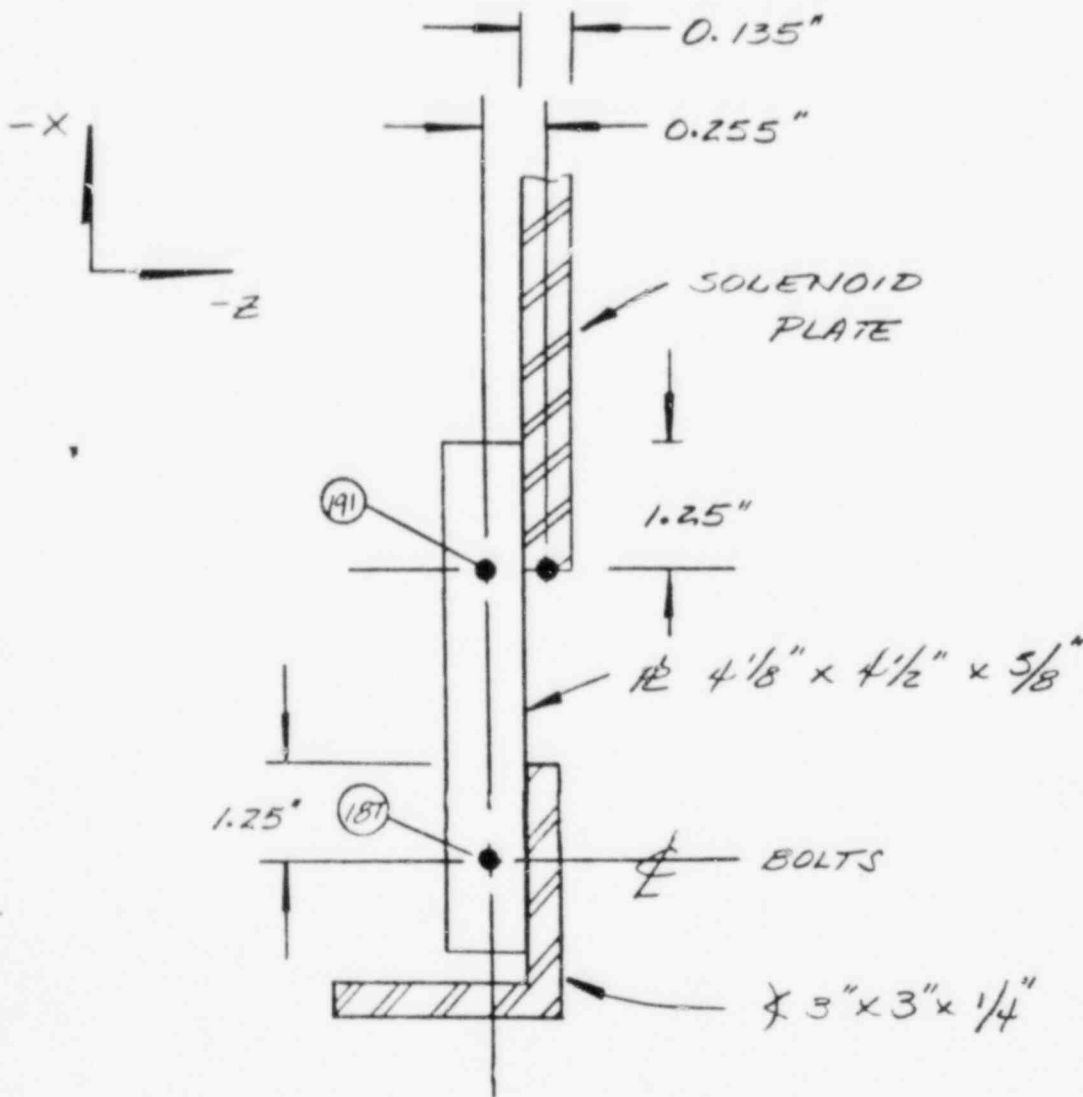




# CALCULATION SHEET

JOB NO. 9645 CALC. NO. Q1277, Q2377 REV. NO. A  
PROJECT MISSISSIPPI POWER & LIGHT COMPANY BY [Signature] DATE 3/8/82  
SUBJECT GRAND GULF NUCLEAR STATION CKD Stephen A. Descoteaux DATE 3/9/82  
SOLENOID MOUNTING PLATE SHEET NO. 4 OF 95

FCN-M-1137

(CONT.)

## OFFSET BEAMS

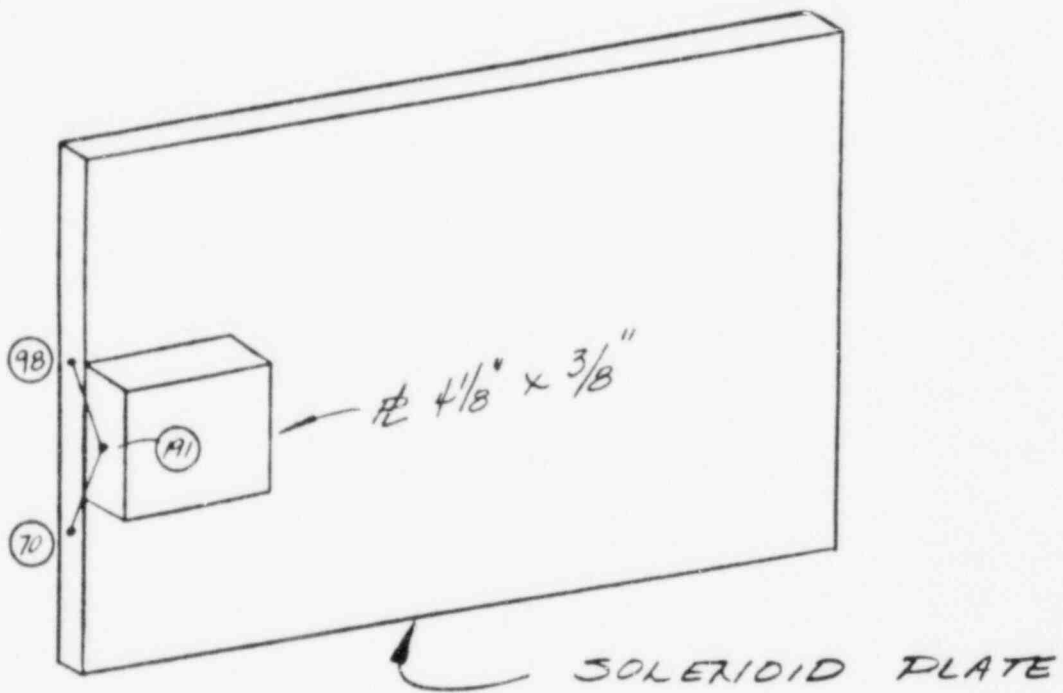

NOTE: OFFSET BEAMS 19, 20 - NODES 70-191 & 191-98 ARE CODED AS TS 4 x 4 x 1/4 TO BE SEMI-RIGID AND TO DISTRIBUTE THE EFFECTS OF THE 4 1/8" x 3/8" OVER THE OVERLAPPING SECTION.



N/A

CHANGE REQUEST/NOTICE

YES NO



JOB NO. 9848

CRN# FCN-M-1138  
PAGE 1 OF 2

REF. DWG. OR SPEC. NO. 9645-AND-1-95-1-1-6-5 REV. 5 TITLE Safety Related

REASON FOR CHANGE/EXISTING CONDITION Automatic Control Overhaul

Add support to stinger external mounting plate on  
actuator Q12776001B,  
CHANGE REQUEST/SKETCH (IF NECESSARY)

As-Built

See Page 2

ATTACHMENT; B, 1 OF 2

FOR INFORMATION ONLY Date: 3/10/82



WPLR# Q12776002-C

PFE APPROVED FOR - SUBMIT TO PROJECT ENGR.

PFE APPROVED FOR - PROCEED WITH WORK

PFE DISAPPROVED

PFE: *R. J. Williams* DATE 1/25/82

PREPARED BY: *George Mahoney* DATE 1/15/82

ACTION BY ENGINEERING - DESCRIPTION OF CHANGE ..

THIS IS: DON # \_\_\_\_\_  
TO DWG # \_\_\_\_\_ REV. \_\_\_\_\_  
SON # \_\_\_\_\_  
TO SPEC # \_\_\_\_\_ REV. \_\_\_\_\_  
DEVIATION # D \_\_\_\_\_  
DATE \_\_\_\_\_  
PAGE \_\_\_\_\_ OF \_\_\_\_\_

REMARKS \_\_\_\_\_ RESP. ENGR. \_\_\_\_\_ DATE \_\_\_\_\_ CHKD: \_\_\_\_\_



GROUP SUPV. \_\_\_\_\_ DATE \_\_\_\_\_

CHIEF ENGINEER \_\_\_\_\_ DATE \_\_\_\_\_ PROJECT ENGR. APPROVAL YES  NO

BAR CHANGES YES  NO  CDT - \_\_\_\_\_ DATE \_\_\_\_\_

TO: C. D. Wood at: L. F. Dale; C. K. McCoy; T. E. Reeves File: 0060/



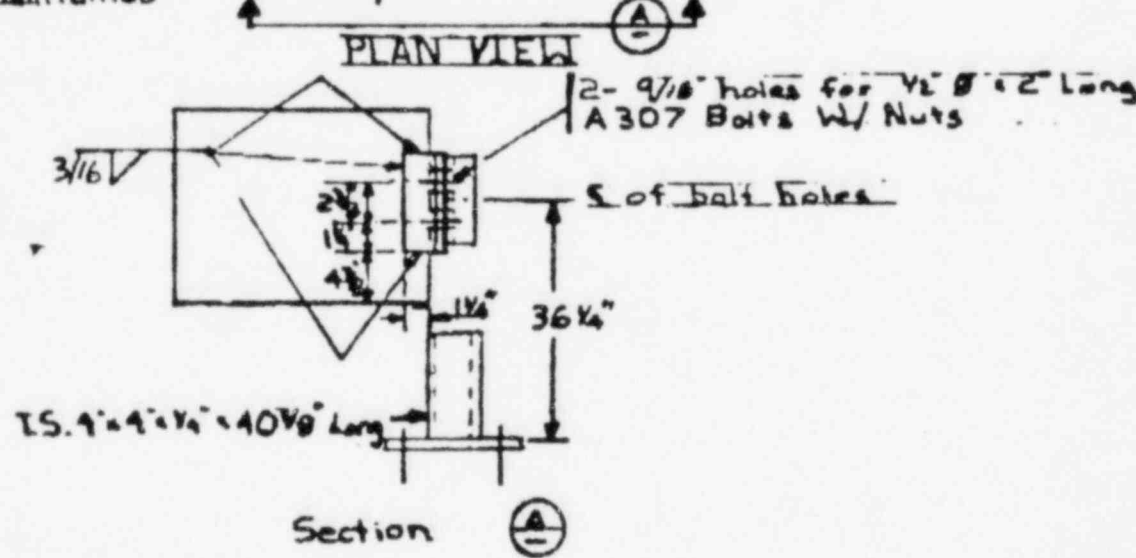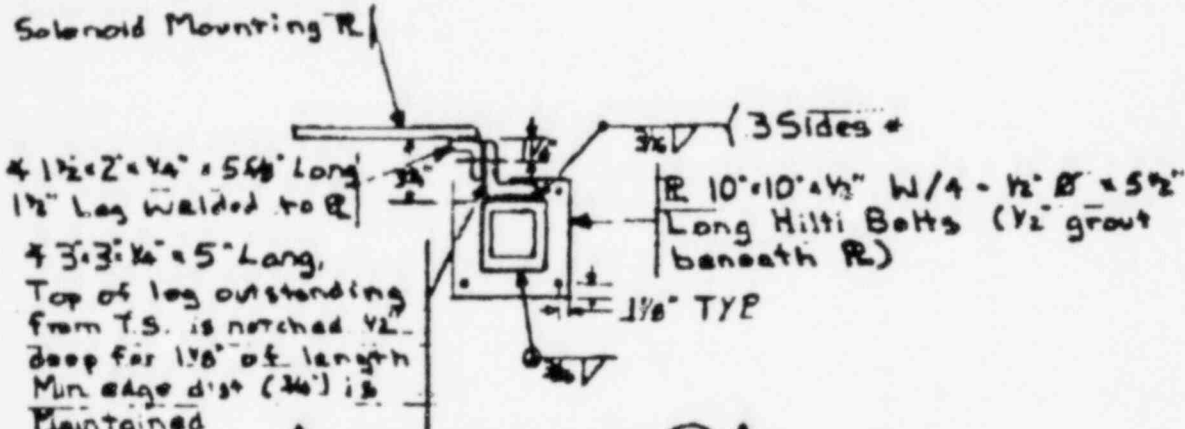

FOR INFORMATION  
ONLY Date: 3/10/02

\* Omit. for side weld

ATTACHMENT; B, 2 OF 2





# CALCULATION SHEET

JOB NO. 9645

CALC NO. Q1377, Q2377

REV. NO. A

PROJECT MISSISSIPPI POWER & LIGHT COMPANY

BY Stephen A. Descoteaux

DATE 2/2/82


SUBJECT GRAND GULF NUCLEAR STATION

CKD Virgil Doyly

DATE MAR 4 82

SOLENOID MOUNTING PLATE

SHEET NO. 5 OF 95

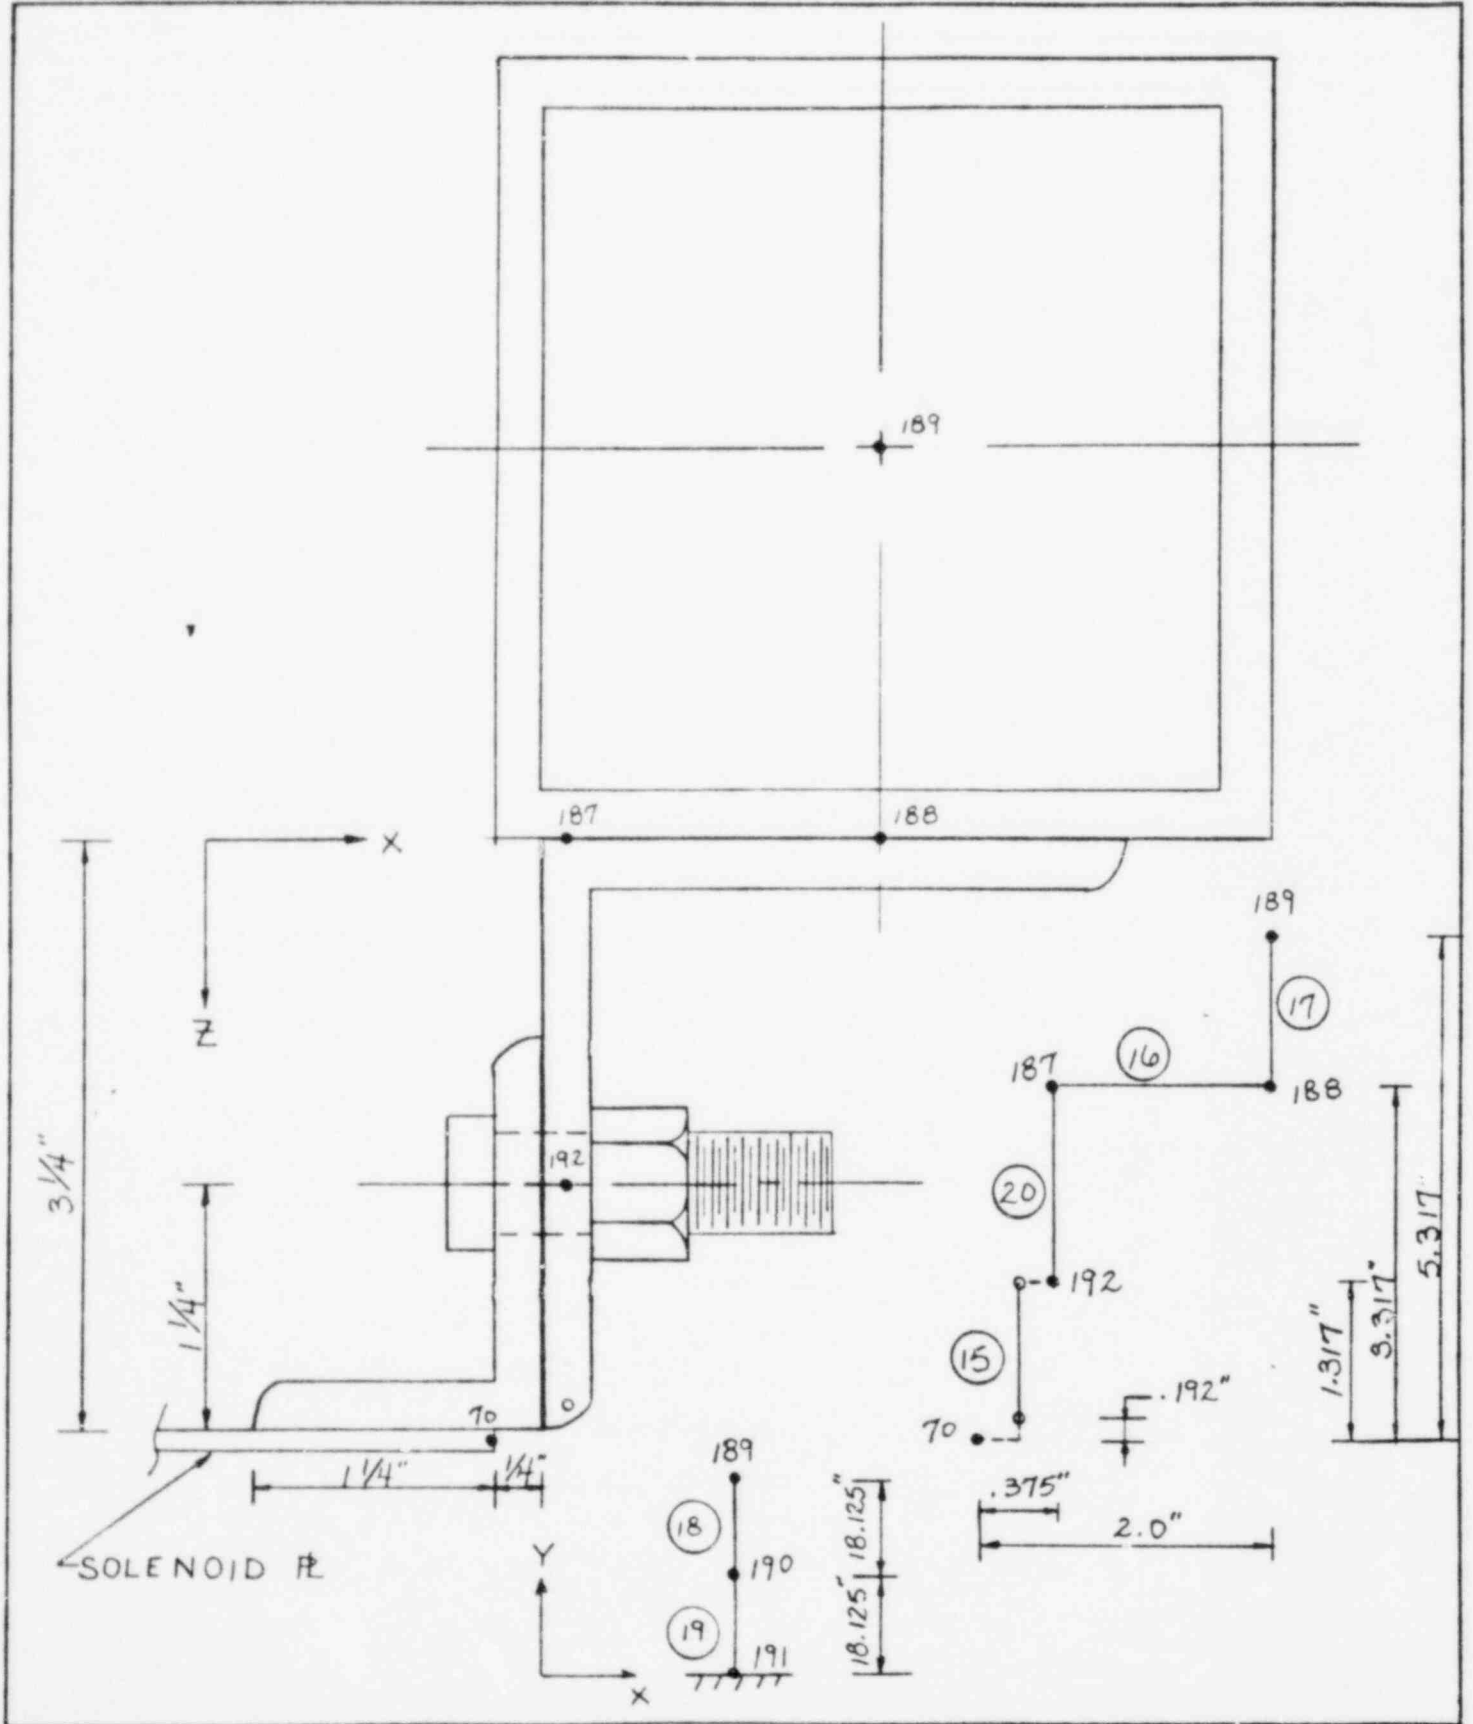



MPL # N/A

CHANGE REQUEST/NOTICE

Q/B NO



JOB NO. 9545

DATE: RN-M-1139  
PAGE 1 OF 2

REF. DWG. OR SPEC. NO. 9545-M-101-QS-11-REV. 5 TITLE Safety Related  
REASON FOR CHANGE/EXISTING CONDITION Automatic Control Diagram

Add supports to stiffen electrical mount plate on  
actuators Q22775001Q.  
CHANGE REQUEST/SKETCH (IF NECESSARY)

As-Built

See page 2

ATTACHMENT; C, 1 OF 2

FOR INFORMATION ONLY Date: 3/10/82



WPBR # Q2277 Q002-L

PFE APPROVED FOR - SUBMIT TO PROJECT ENG.   
PFE APPROVED FOR - PROCEED WITH WORK   
PFE DISAPPROVED   
PFE: [Signature] DATE 1/27/82

PREPARED BY: [Signature] DATE 1/15/82

ACTION BY ENGINEERING - DESCRIPTION OF CHANGE --  
THIS IS: DON # \_\_\_\_\_  
TO DWG # \_\_\_\_\_ REV. \_\_\_\_\_  
SON # \_\_\_\_\_  
TO SPEC # \_\_\_\_\_ REV. \_\_\_\_\_  
DEVIATION # 0 \_\_\_\_\_  
DATE \_\_\_\_\_  
PAGE \_\_\_\_ OF \_\_\_\_

REMARKS \_\_\_\_\_ RESP. ENGR: \_\_\_\_\_ DATE \_\_\_\_\_ CHKD: \_\_\_\_\_  
GROUP SUPV. \_\_\_\_\_ DATE \_\_\_\_\_  
CHIEF ENGINEER \_\_\_\_\_ DATE \_\_\_\_\_ PROJECT ENGR. APPROVAL YES  NO   
CDT - \_\_\_\_\_ DATE \_\_\_\_\_  
BAR CHANGES YES  NO


TO: C. D. Wood cc: L. P. Dale; G. K. McCoy; T. E. Reeves File: 0080/

SUPPLEMENTAL SHEET  
CHANGE REQUEST/NOTICE


PCN  
GRANT NO. M-1139

PAGE 2 OF 2

Existing  $4 \times 3 \times \frac{1}{4}$ " HVAC Hanger Q2Z77G002HG4

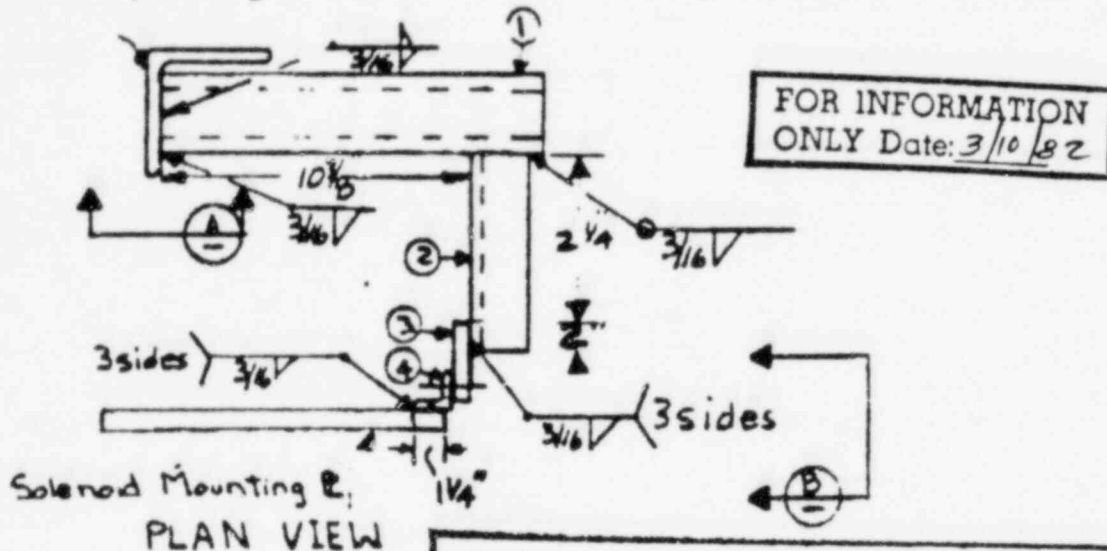


ATTACHMENT; C, 2 OF 2

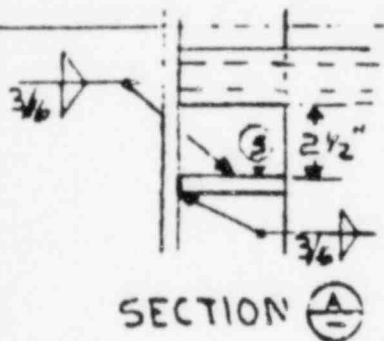

Min. Edge Dist. ( $\frac{1}{16}$ ") are Maintained

Item 3 notched in location shown  $\frac{1}{2}$ " deep x  $1 \frac{1}{2}$ " long; Item 4 notched in location shown  $\frac{1}{4}$ " deep x 2" long

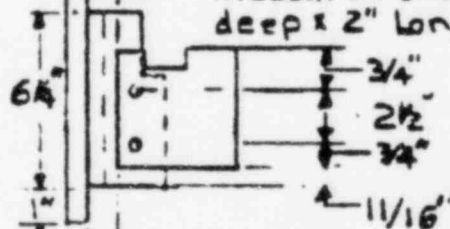

BILL OF MATERIALS

Item #	Description
1	TS $2 \times 2 \times \frac{1}{4}$ " x 13" long
2	$\times 1 \frac{1}{2} \times 1 \frac{1}{2} \times \frac{1}{4}$ " x $4 \frac{1}{4}$ " long
3	P $4 \times 4 \times \frac{3}{8}$ "
4	$\times 2 \times 1 \frac{1}{2} \times \frac{1}{4}$ " x $6 \frac{1}{4}$ " long
5	P $2 \frac{3}{4} \times 2 \frac{3}{4} \times \frac{3}{16}$ "
6	2 - $9/16$ " $\emptyset$ holes for 2 - $\frac{1}{2}$ " x 135 - 3 - hole nuts



# CALCULATION SHEET

JOB NO. 9645

CALC. NO. Q1277, Q1277

REV. NO. A

PROJECT MISSISSIPPI POWER & LIGHT COMPANY

BY David Mettles

DATE 2-16-82

SUBJECT GRAND GULF NUCLEAR STATION

CKD Viril Group of.


DATE 2-26-82

SOLENOID MOUNTING PLATE


SHEET NO. 6 OF 95

ASSUME THAT NEUTRAL AXES OF ALL MEMBERS ARE AT THE SAME ELEV. ON SECTION A-A

FCN-M-1139

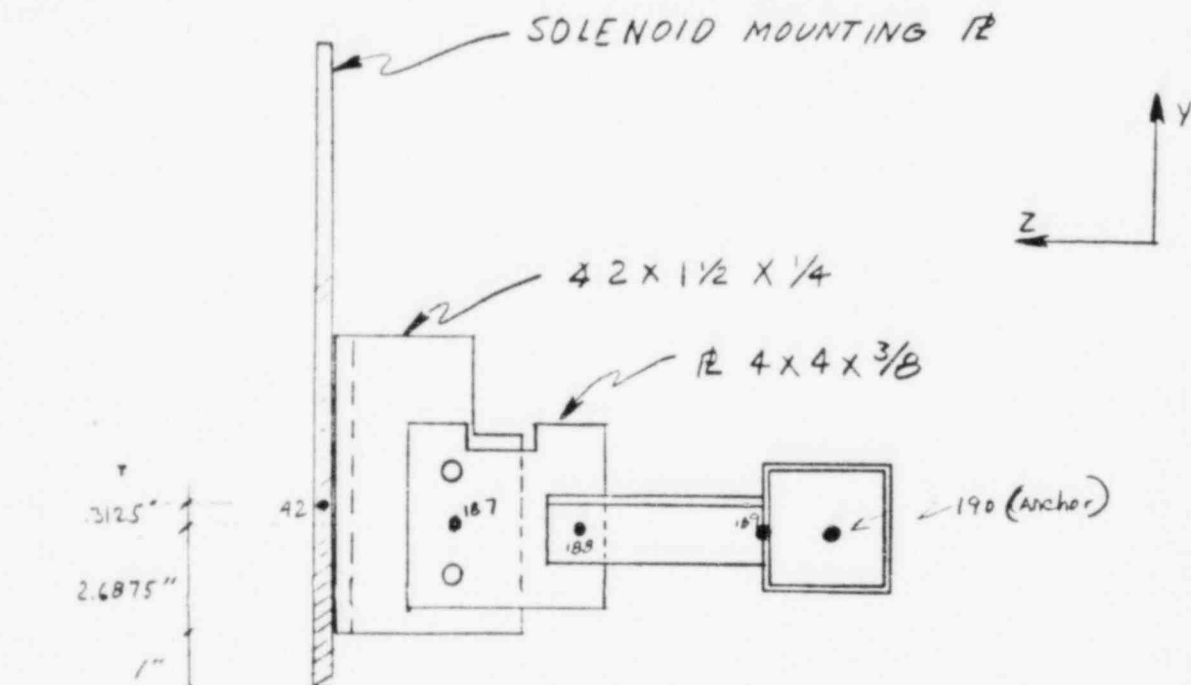

SECTION A-A

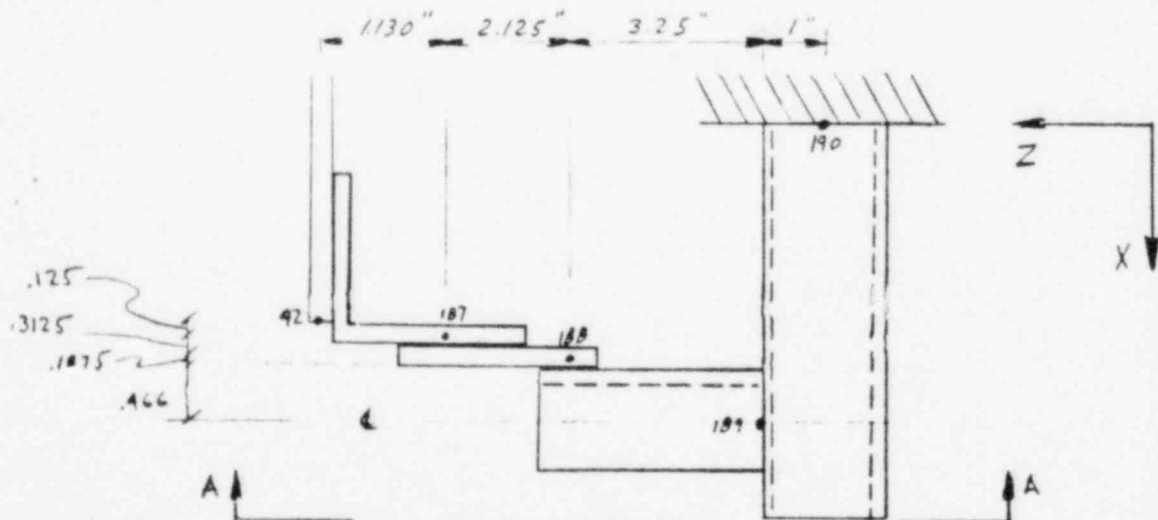

PLAN VIEW

FROM NODE	TO NODE	SECTION
42	187	SOLID RECTANGULAR 6 1/4 x 1/4
187	188	SOLID RECTANGULAR 3 1/2 x 3/8
188	189	4 1 1/2 x 1 1/2 x 1/4
189	190	TS 2 x 2 x 1/4



MPL #

N/A

CHANGE REQUEST/NOTICE

OR  
NO

JOB NO. 9645

DRAW # EN-M-115/PAGE 1 OF 2REF. DWG. OR SPEC. NO. 9645-1-11-1-1-1 REV. 1TITLE Safety Analysis

REASON FOR CHANGE/EXISTING CONDITION

Automatic Control DamperAdd support to slotted aluminum mounting plate on motor Q1E71036A

CHANGE REQUEST/SKETCH (IF NECESSARY)

As-Built

SEE PAGE 2

ATTACHMENT; D, 1 OF 2FOR INFORMATION  
ONLY Date: 3/10/82

WPAR/ Q1E71036A-C

PFE APPROVED FOR - SUBMIT TO PROJECT ENGR. PFE APPROVED FOR - PROCEED WITH WORK PFE DISAPPROVED PFE: R. H. AndersonDATE 1/24/82PREPARED BY: Max DATE 1/15/82

ACTION BY ENGINEERING - DESCRIPTION OF CHANGE ..

THIS IS: DCN # \_\_\_\_\_

TO DWG # \_\_\_\_\_ REV. \_\_\_\_\_

SCH # \_\_\_\_\_

TO SPEC. # \_\_\_\_\_ REV. \_\_\_\_\_

DEVIATION # 0

DATE \_\_\_\_\_

PAGE \_\_\_\_\_ OF \_\_\_\_\_

REMARKS \_\_\_\_\_

RESP. ENGR: \_\_\_\_\_ DATE \_\_\_\_\_ CHKD: \_\_\_\_\_

GROUP SUPV. \_\_\_\_\_ DATE \_\_\_\_\_

CHIEF ENGINEER \_\_\_\_\_ DATE \_\_\_\_\_

PROJECT ENGR. APPROVAL YES  NO BAR CHANGES YES  NO 


CDT - \_\_\_\_\_ DATE \_\_\_\_\_

TO: C. D. Wood as: L. P. Dale; C. K. McCoy; T. E. Rouse File: 0080/





# CALCULATION SHEET

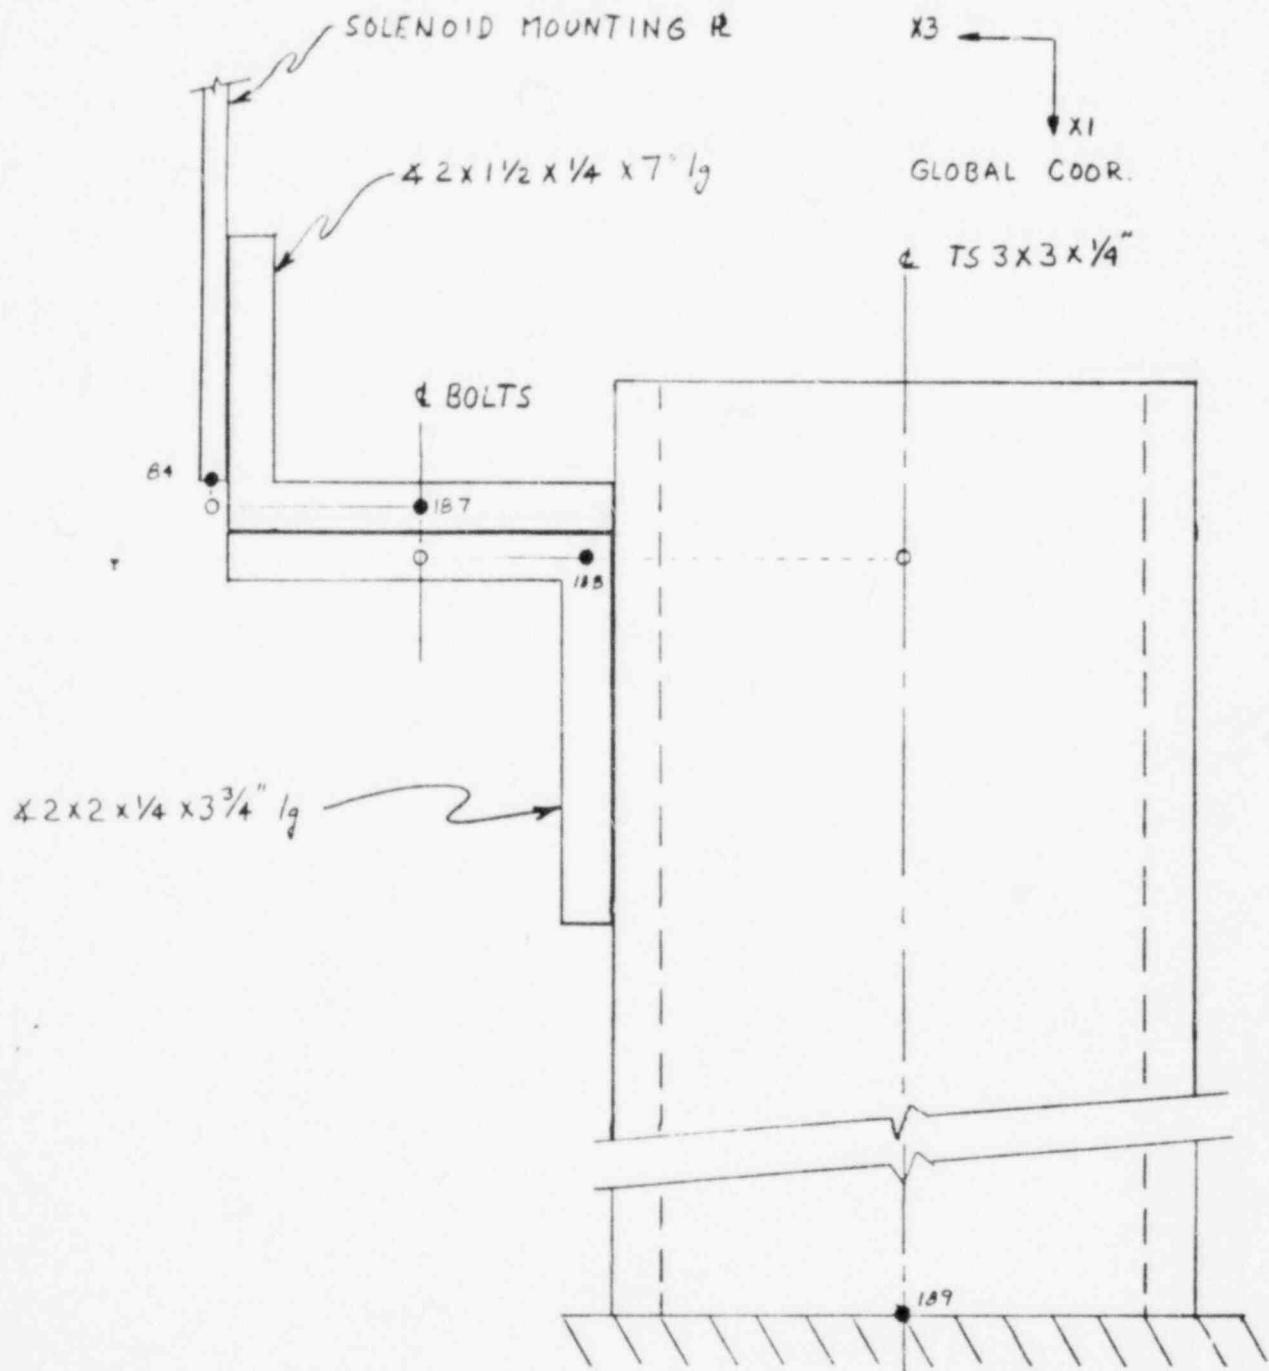JOB NO. 9645CALC. NO. Q1277, Q2277 REV. NO. APROJECT MISSISSIPPI POWER & LIGHT COMPANYBY David Matthe DATE 2-12-82SUBJECT GRAND GULF NUCLEAR STATIONCKD [Signature] DATE 2-17-82SOLENOID MOUNTING PLATESHEET NO. 7 OF 95FCN-41-1151

FROM NODE	TO NODE	SECTION
84	187	SOLID RECTANGLE 7" x 1/4"
187	188	SOLID RECTANGLE 3 3/4" x 1/4"
188	189	TS 3 x 3 x 1/4"





REF. NO. N/A

CHANGE REQUEST/NOTICE

NO.



JOB NO. 0645

CRAN # FCN-1150

PAGE 1 OF 2

REF. DWG. OR SPEC. NO. 9645-M-617.1-QS-1.1-6-REV. 5 TITLE State Related

REASON FOR CHANGE/EXISTING CONDITION Auto. Coated Rampart

Add support to existing welded manway plate on  
actuator Q2E77G007A.

CHANGE REQUEST/SKETCH (IF NECESSARY)

As-Built

See Page 2

ATTACHMENT; E, 1 OF 2

FOR INFORMATION ONLY Date: 3/10/82



WPAR# Q2E77G00A-C

PFE APPROVED FOR - SUBMIT TO PROJECT ENGR.   
PFE APPROVED FOR - PROCEED WITH WORK   
PFE DISAPPROVED   
PFE: Rd Alexander DATE 2/6/82

PREPARED BY: Dennis Maloney DATE 1/15/82

ACTION BY ENGINEERING - DESCRIPTION OF CHANGE --

THIS IS: DON # \_\_\_\_\_  
TO DWG # \_\_\_\_\_ REV. \_\_\_\_\_  
SCH # \_\_\_\_\_  
TO SPEC # \_\_\_\_\_ REV. \_\_\_\_\_  
DEVIATION # D  
DATE \_\_\_\_\_  
PAGE \_\_\_\_\_ OF \_\_\_\_\_

REMARKS \_\_\_\_\_ RESP. ENGR. \_\_\_\_\_ DATE \_\_\_\_\_ CHKD: \_\_\_\_\_

GROUP SUPV. \_\_\_\_\_ DATE \_\_\_\_\_

CHIEF ENGINEER \_\_\_\_\_ DATE \_\_\_\_\_

PROJECT ENGR. APPROVAL YES  NO

EAR CHANGES YES  NO

CDT - \_\_\_\_\_ DATE \_\_\_\_\_

TO: C. D. Wood ac: L. F. Dale; C. K. McCoy; T. E. Reeves File: 0080

FOR INFORMATION ONLY Date: 3/10/82


SUPPLEMENTAL SHEET  
CHANGE REQUEST/NOTICE

ECN -  
GRAN No. M-1150


PAGE 2 OF 2

ATTACHMENT; E, 2 OF 2


Existng \* 5.5" x 3/8" HVAC  
Duct Support - 025776 204 ± .15

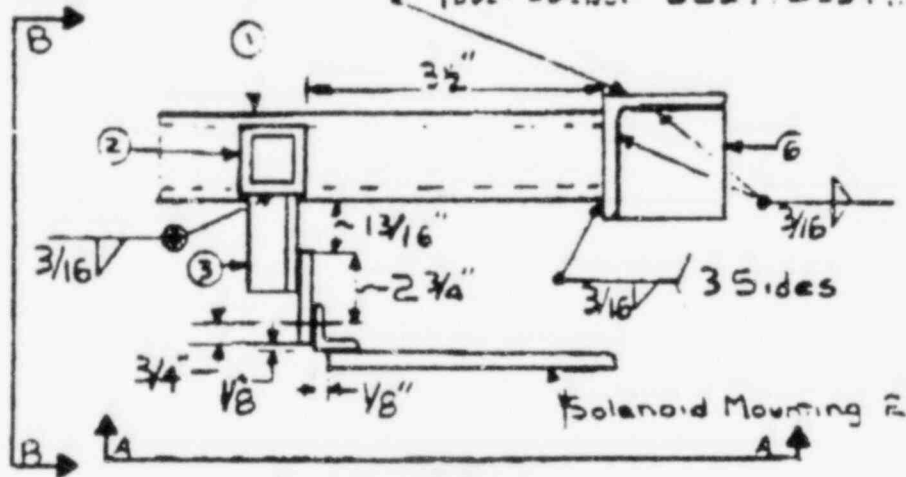

PLAN VIEW

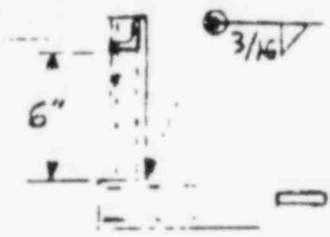

Section A-A  
Parts Omitted for Clarity

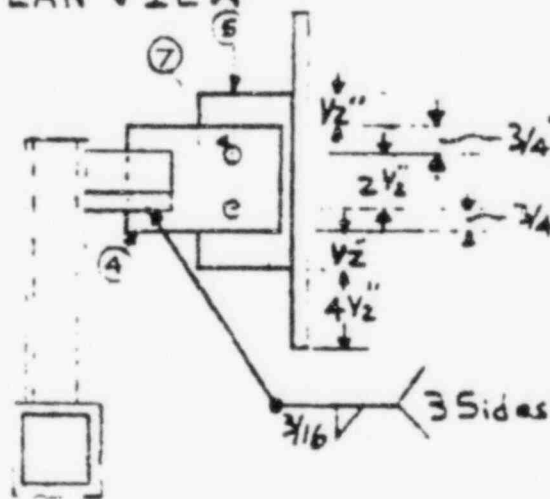

BILL OF MATERIALS

ITEM #	DESCRIPTION
1	TS 4" x 4" x 1/4" = 6 7/8
2	TS 3" x 3" x 1/4" = 9 1/2
3	* 2 x 2 x 1/4" = 2 1/2
4	R 4" x 3 1/2" x 3/8"
5	* = 6 1/2" x 1/4" x 5" Long
6	R 4 1/2" x 4 1/2" x 3/8"
7	2 - 9/16" Ø Holes for 2 - A-307 Bolts w/ Nuts



2



# CALCULATION SHEET

JOB NO. 9645

CALC. NO. Q1277, Q2277 REV. NO. A

PROJECT MISSISSIPPI POWER & LIGHT COMPANY

BY Richard Matthe DATE 2-17-82



SUBJECT GRAND GULF NUCLEAR STATION

CKD Stephen A. Descoteaux DATE 3/1/82

Selenoid Mounting Plate Q2277E023A

SHEET NO. 8 OF 95

FCN - M - 1150

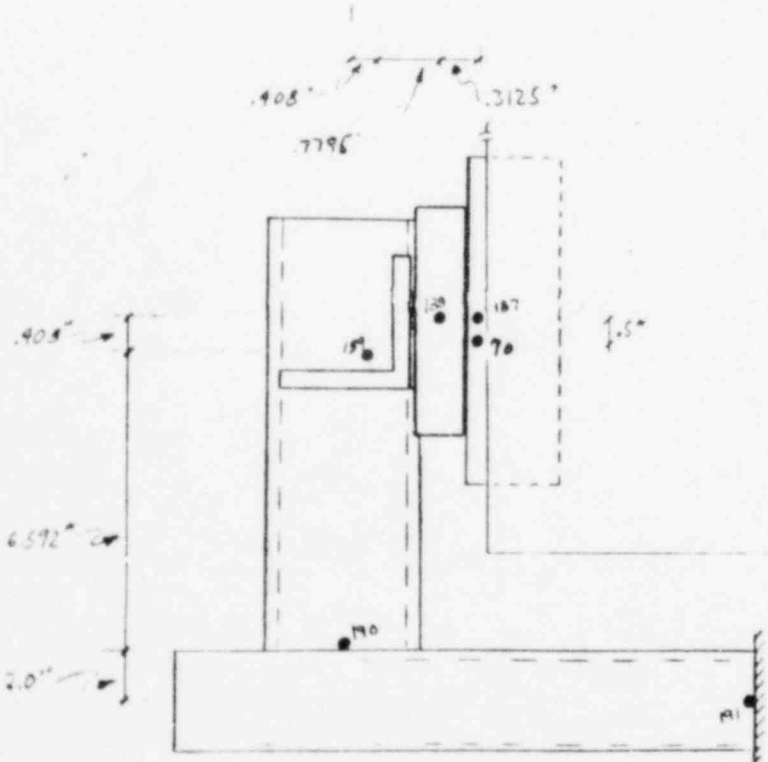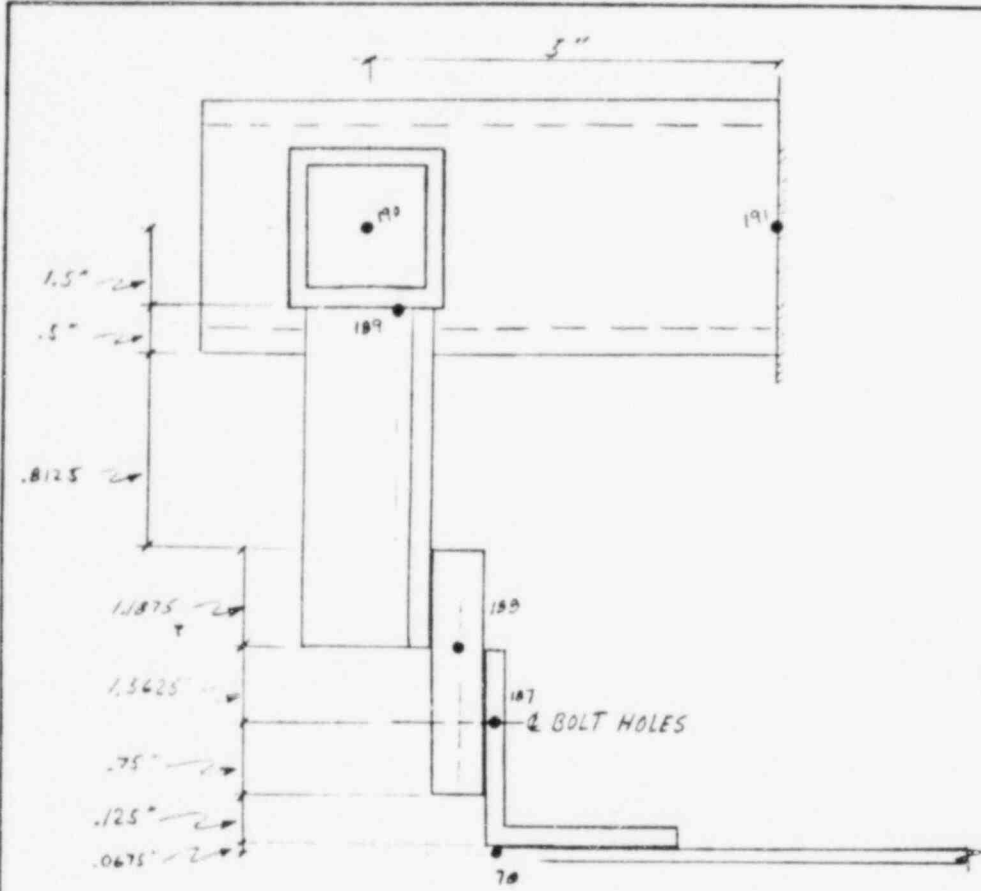



# CALCULATION SHEET

JOB NO. 9645CALC. NO. Q1277, Q2277 REV. NO. APROJECT MISSISSIPPI POWER & LIGHT COMPANYBY David M. Miller DATE 2-17-82SUBJECT GRAND GULF NUCLEAR STATIONCKD Stephen A. Decoteaux DATE 3/1/82Solenoid Mounting Plate Q2277F003ASHEET NO. 9 OF 95

FROM NODE	TO NODE	SECTION
84	187	SOLID RECTANGLE 5 x 1/4
137	188	SOLID RECTANGLE 4 x 3/8
188	189	2 x 2 x 1/4
189	190	TS 3 x 3 x 1/4
190	191	TS 4 x 4 x 1/4



AMPL # N/A

CHANGE REQUEST/NOTICE  NO



JOB NO. 8645

CRN# FCN-M-1152  
PAGE 1 OF 2

REF. DWG. OR SPEC. NO. 245-A-1071-02-11-11-1 REV. 1 TITLE Safety Related  
REASON FOR CHANGE/EXISTING CONDITION Automatic Control Damper

Add support to existing solenoid mounting plate on actuator Q22776035A.  
CHANGE REQUEST/SKETCH (IF NECESSARY)

As-Built

See Page 2

ATTACHMENT; F, 1 OF 2

FOR INFORMATION ONLY Date: 3/10/82



WP&R# Q22776004C

PFE APPROVED FOR - SUBMIT TO PROJECT ENGR.   
PFE APPROVED FOR - PROCEED WITH WORK   
PFE DISAPPROVED   
PFE: R. H. ... DATE 2/12/82

PREPARED BY: Darryl Malou DATE 1/15/82

ACTION BY ENGINEERING - DESCRIPTION OF CHANGE ..

THIS IS: DCN # \_\_\_\_\_  
TO DWG # \_\_\_\_\_ REV. \_\_\_\_\_  
SON # \_\_\_\_\_  
TO SPEC # \_\_\_\_\_ REV. \_\_\_\_\_  
DEVIATION # 0  
DATE \_\_\_\_\_  
PAGE \_\_\_\_\_ OF \_\_\_\_\_

REMARKS \_\_\_\_\_ RESP. ENGR: \_\_\_\_\_ DATE \_\_\_\_\_ CHKD: \_\_\_\_\_

GROUP SUPV. \_\_\_\_\_ DATE \_\_\_\_\_

CHIEF ENGINEER \_\_\_\_\_ DATE \_\_\_\_\_ PROJECT ENGR. APPROVAL YES  NO

BAR CHANGES YES  NO  DOT - \_\_\_\_\_ DATE \_\_\_\_\_


TO: C. D. Wood as: L. F. Dan; C. K. McCoy; T. E. Reeves F# 0080

(3)

SUPPLEMENTAL SHEET


CHANGE REQUEST NOTICE

Existing  $4 \times 3 \frac{1}{2} \times 3 \frac{1}{2} \times \frac{1}{2}$  : HVAC  
Duct Suppl - G2277G004 H12

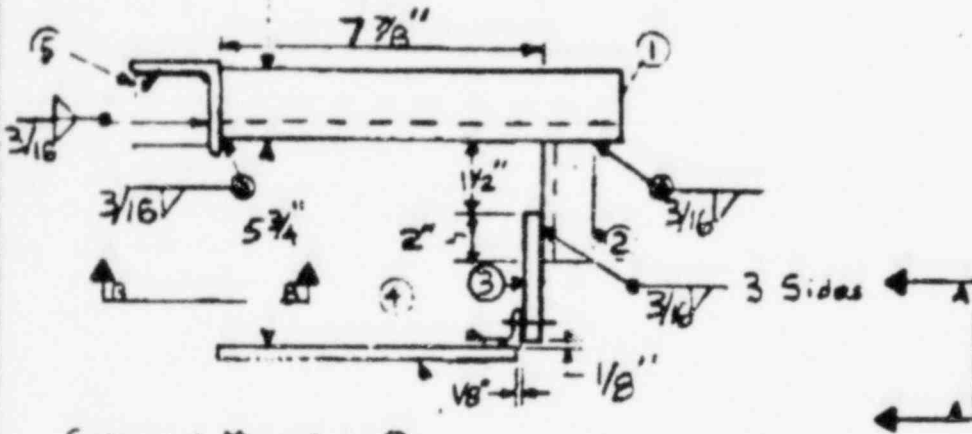

Solenoid Mounting P.

PLAN VIEW

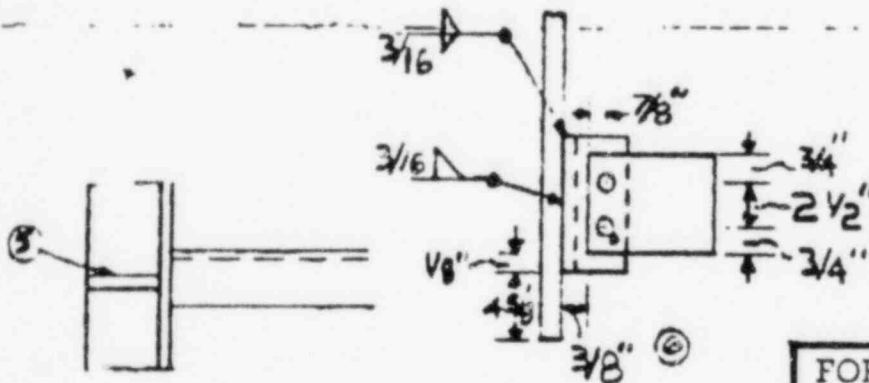

Section B-B

Section A-A

FOR INFORMATION  
ONLY Date: 3/10/82

Bill of Materials

ATTACHMENT; F, 2 OF 2

Item	Description
1	$\times 2 \times 2 \times \frac{1}{4} \times 10 \frac{1}{2}$ Long
2	$\times 1 \frac{1}{2} \times 1 \frac{1}{2} \times \frac{1}{4} \times 3 \frac{1}{2}$ Long
3	R $4 \times 4 \times \frac{3}{8}$
4	$\times 2 \times 1 \frac{1}{2} \times \frac{1}{4} \times 7$ Long
5	R $3 \times 3 \times \frac{3}{8}$
6	2 - $\frac{7}{16}$ F holes for A307 Bolts & NUTS



# CALCULATION SHEET

JOB NO. 9645

CALC NO. Q1277, Q2277 REV. NO. A

PROJECT MISSISSIPPI POWER & LIGHT COMPANY



BY Stephen A. Descoteaux DATE 2/8/82

SUBJECT GRAND GULF NUCLEAR STATION

CKD Dick. Damp DATE MAR 0. 82

SOLENOID MOUNTING PLATE

SHEET NO. 10 OF 95

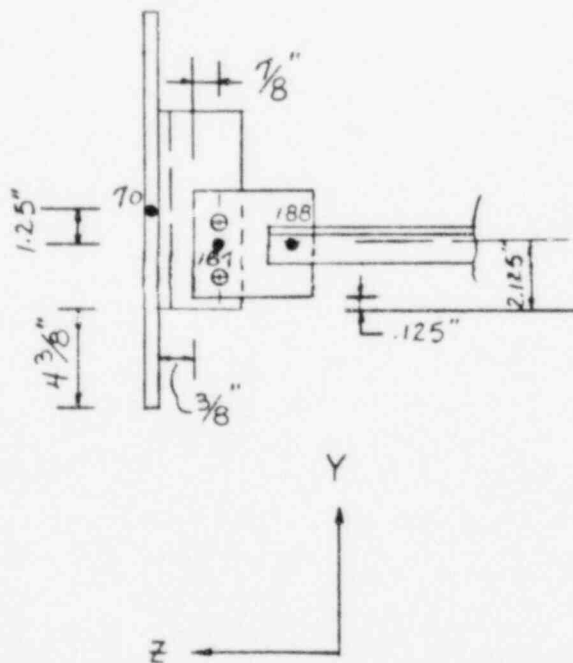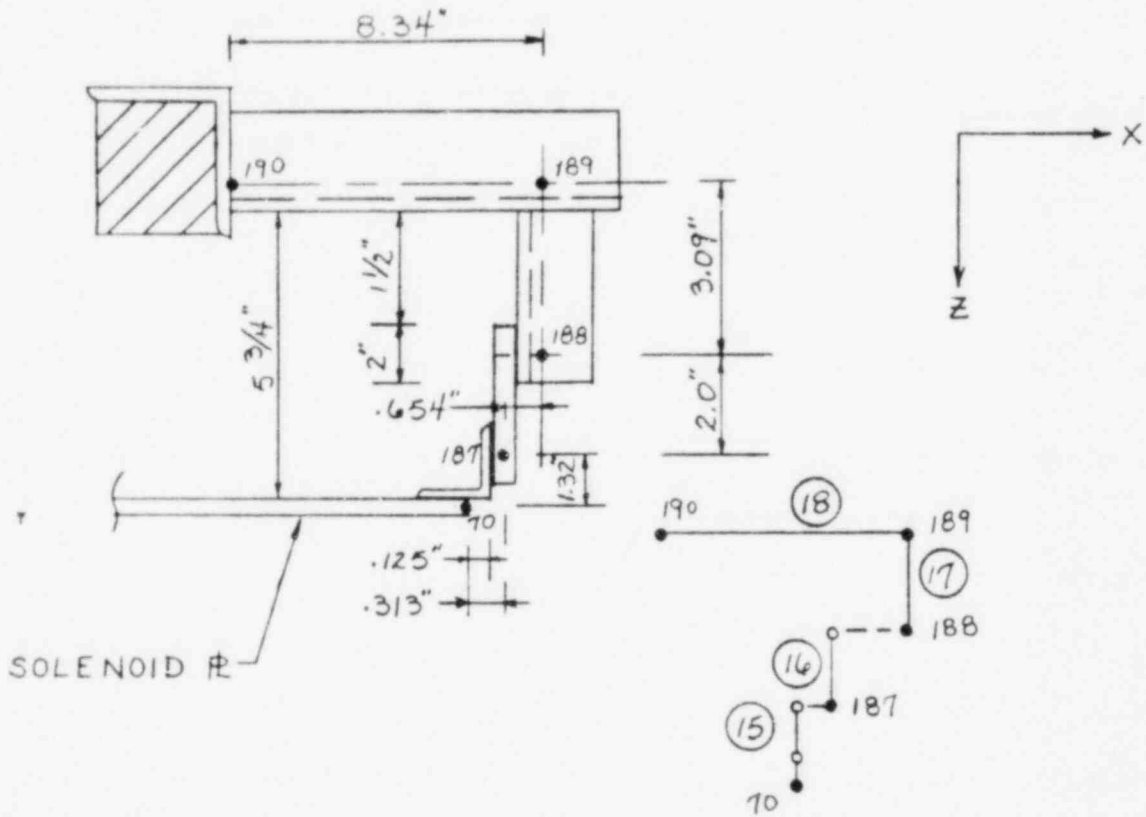



MPL # N/A

CHANGE REQUEST/NOTICE

0 2  
NO 1



JOB NO. 9648

WORK FCN-M-1149  
PAGE 1 OF 3

REF. DWG. OR SPEC. NO. 9648-M-101-06-11-65 REV. 5 TITLE Safety Related

REASON FOR CHANGE/EXISTING CONDITION Auto Control Dampers

Add support to stiffen solenoid mounting plate on actuator Q1277603A.

CHANGE REQUEST/SKETCH (IF NECESSARY)

As-Built

See pages 2 & 3

ATTACHMENT; 6, 1 OF 3

FOR INFORMATION ONLY Date: 3/10/82



WP&R # Q12776004-C

PFE APPROVED FOR - SUBMIT TO PROJECT ENGR.   
PFE APPROVED FOR - PROCEED WITH WORK   
PFE DISAPPROVED   
PFE: *[Signature]* DATE 2/3/82

PREPARED BY: *[Signature]* DATE 1/15/82

ACTION BY ENGINEERING - DESCRIPTION OF CHANGE --

THIS IS: DCN # \_\_\_\_\_  
TO DWG # \_\_\_\_\_ REV. \_\_\_\_\_  
SON # \_\_\_\_\_  
TO SPEC # \_\_\_\_\_ REV. \_\_\_\_\_  
DEVIATION # D \_\_\_\_\_  
DATE \_\_\_\_\_  
PAGE \_\_\_\_\_ OF \_\_\_\_\_

REMARKS \_\_\_\_\_ RESP. ENGR: \_\_\_\_\_ DATE \_\_\_\_\_ CHKD: \_\_\_\_\_

GROUP SUPV. \_\_\_\_\_ DATE \_\_\_\_\_

CHIEF ENGINEER \_\_\_\_\_ DATE \_\_\_\_\_ PROJECT ENGR. APPROVAL YES  NO

BAR CHANGES YES  NO  CDT - \_\_\_\_\_ DATE \_\_\_\_\_

TO: C. D. Wood as: L. F. Dale; C. K. McCoy; T. E. Reeves File: 0080


(5)



SUPPLEMENTAL SHEET  
CHANGE REQUEST/NOTICE


FCN -  
GRAIN No. M-1149

PAGE 2 OF 3

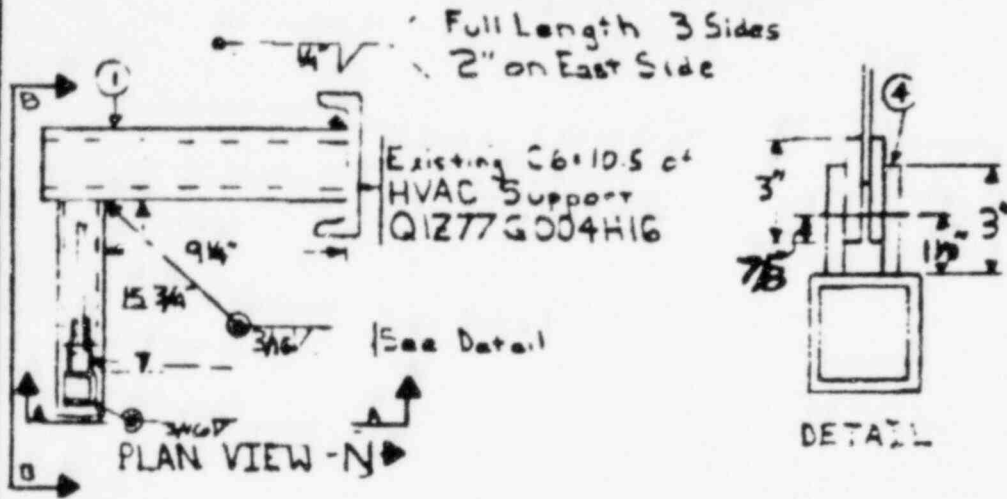

ATTACHMENT; 6, 2 OF 3

FOR INFORMATION  
ONLY Date: 3/10/82

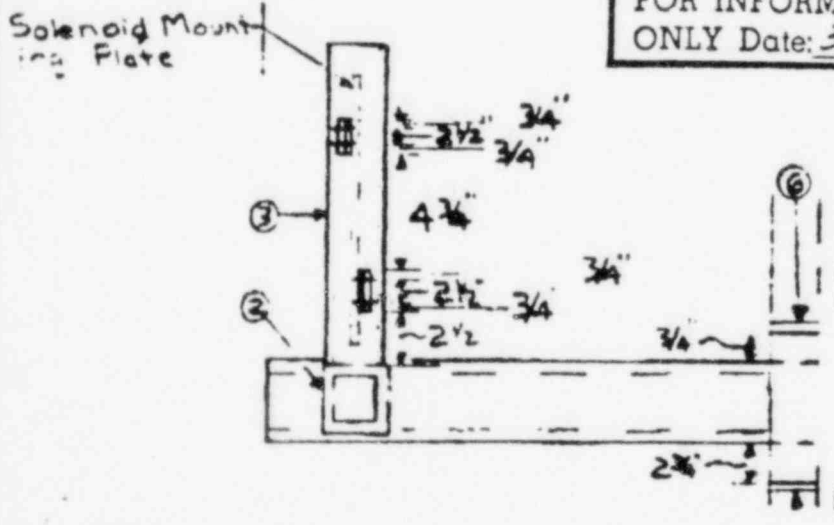

Section A-A

TYPE 3 Sides  
= 0 Sides




6

SUPPLEMENTAL SHEET  
CHANGE REQUEST/NOTICE

FCW-  
OPRN No. M-149

PAGE 3 OF 3

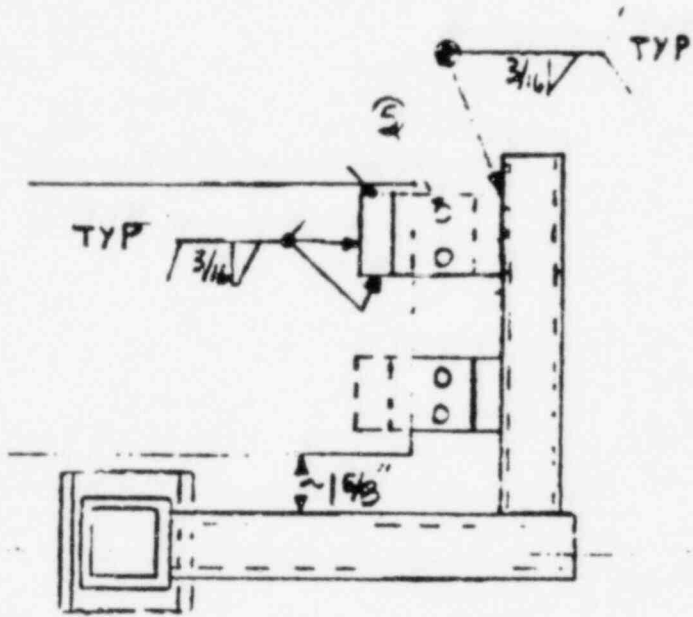

Section B-B

Bill of Materials

Item	Description
1	TS 4 x 4 x 13 long
2	TS 3 x 3 x 19 1/2 long
3	TS 2 1/2 x 2 1/2 x 14 x 16 1/2 long
4	R 4 x 3 x 1/8 (4 total)
5	9/16 holes for 1/2 A307 Bolts w/Nuts (4 total)
6	R 2 x 5/2 x 3/8 (2 total)


ATTACHMENT; 6, 3 OF 3

FOR INFORMATION  
ONLY Date: 3/10/82

Q 7



# CALCULATION SHEET

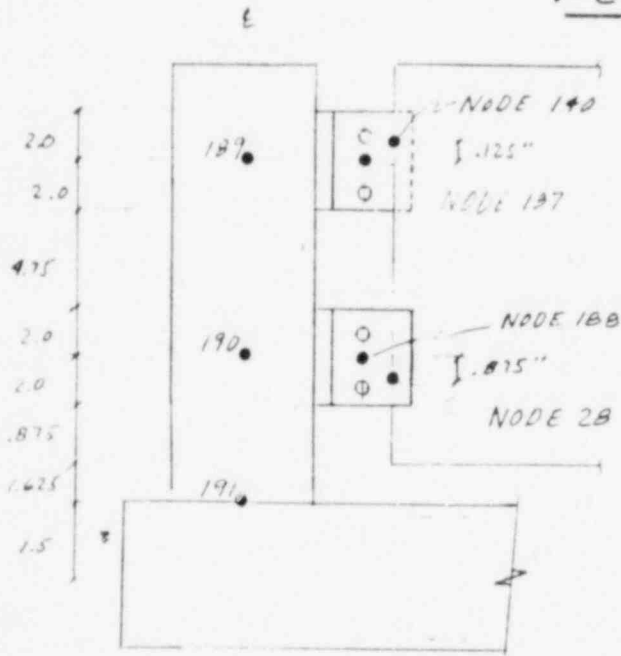JOB NO 9645CALC. NO Q1277, Q2277 REV. NO. APROJECT MISSISSIPPI POWER & LIGHT COMPANYBY [Signature] DATE 2/18/82SUBJECT GRAND GULF NUCLEAR STATIONCKD U. L. Noyes DATE FEB 26, 82Solenoid Mounting Plate Q1277F003ASHEET NO. 11 OF 95FCN - M - 1149SECTION A-A

FROM NODE	TO NODE	SECTION
140	137	SOLID RECTANGLE 4 x 3/8
23	135	SOLID RECTANGLE 4 x 3/8
137	137	SOLID RECTANGLE 4 x 3/8
188	190	SOLID RECTANGLE 4 x 3/8
137	170	TS 2 1/2 x 2 1/2 x 1/4
190	171	TS 2 1/2 x 2 1/2 x 1/4
191	192	TS 3 x 3 x 1/4
192	193	TS 4 x 4 x 1/4



# CALCULATION SHEET

JOB NO. 9645

CALC. NO. Q1Z77, Q2Z77 REV. NO. A

PROJECT MISSISSIPPI POWER & LIGHT COMPANY


BY Robert Mittle DATE 2/18/82

SUBJECT GRAND GULF NUCLEAR STATION

CKD W. J. Gray DATE FEB. 26. 82

Solenoid Mounting Plate Q1Z77F003A

SHEET NO. 12 OF 95

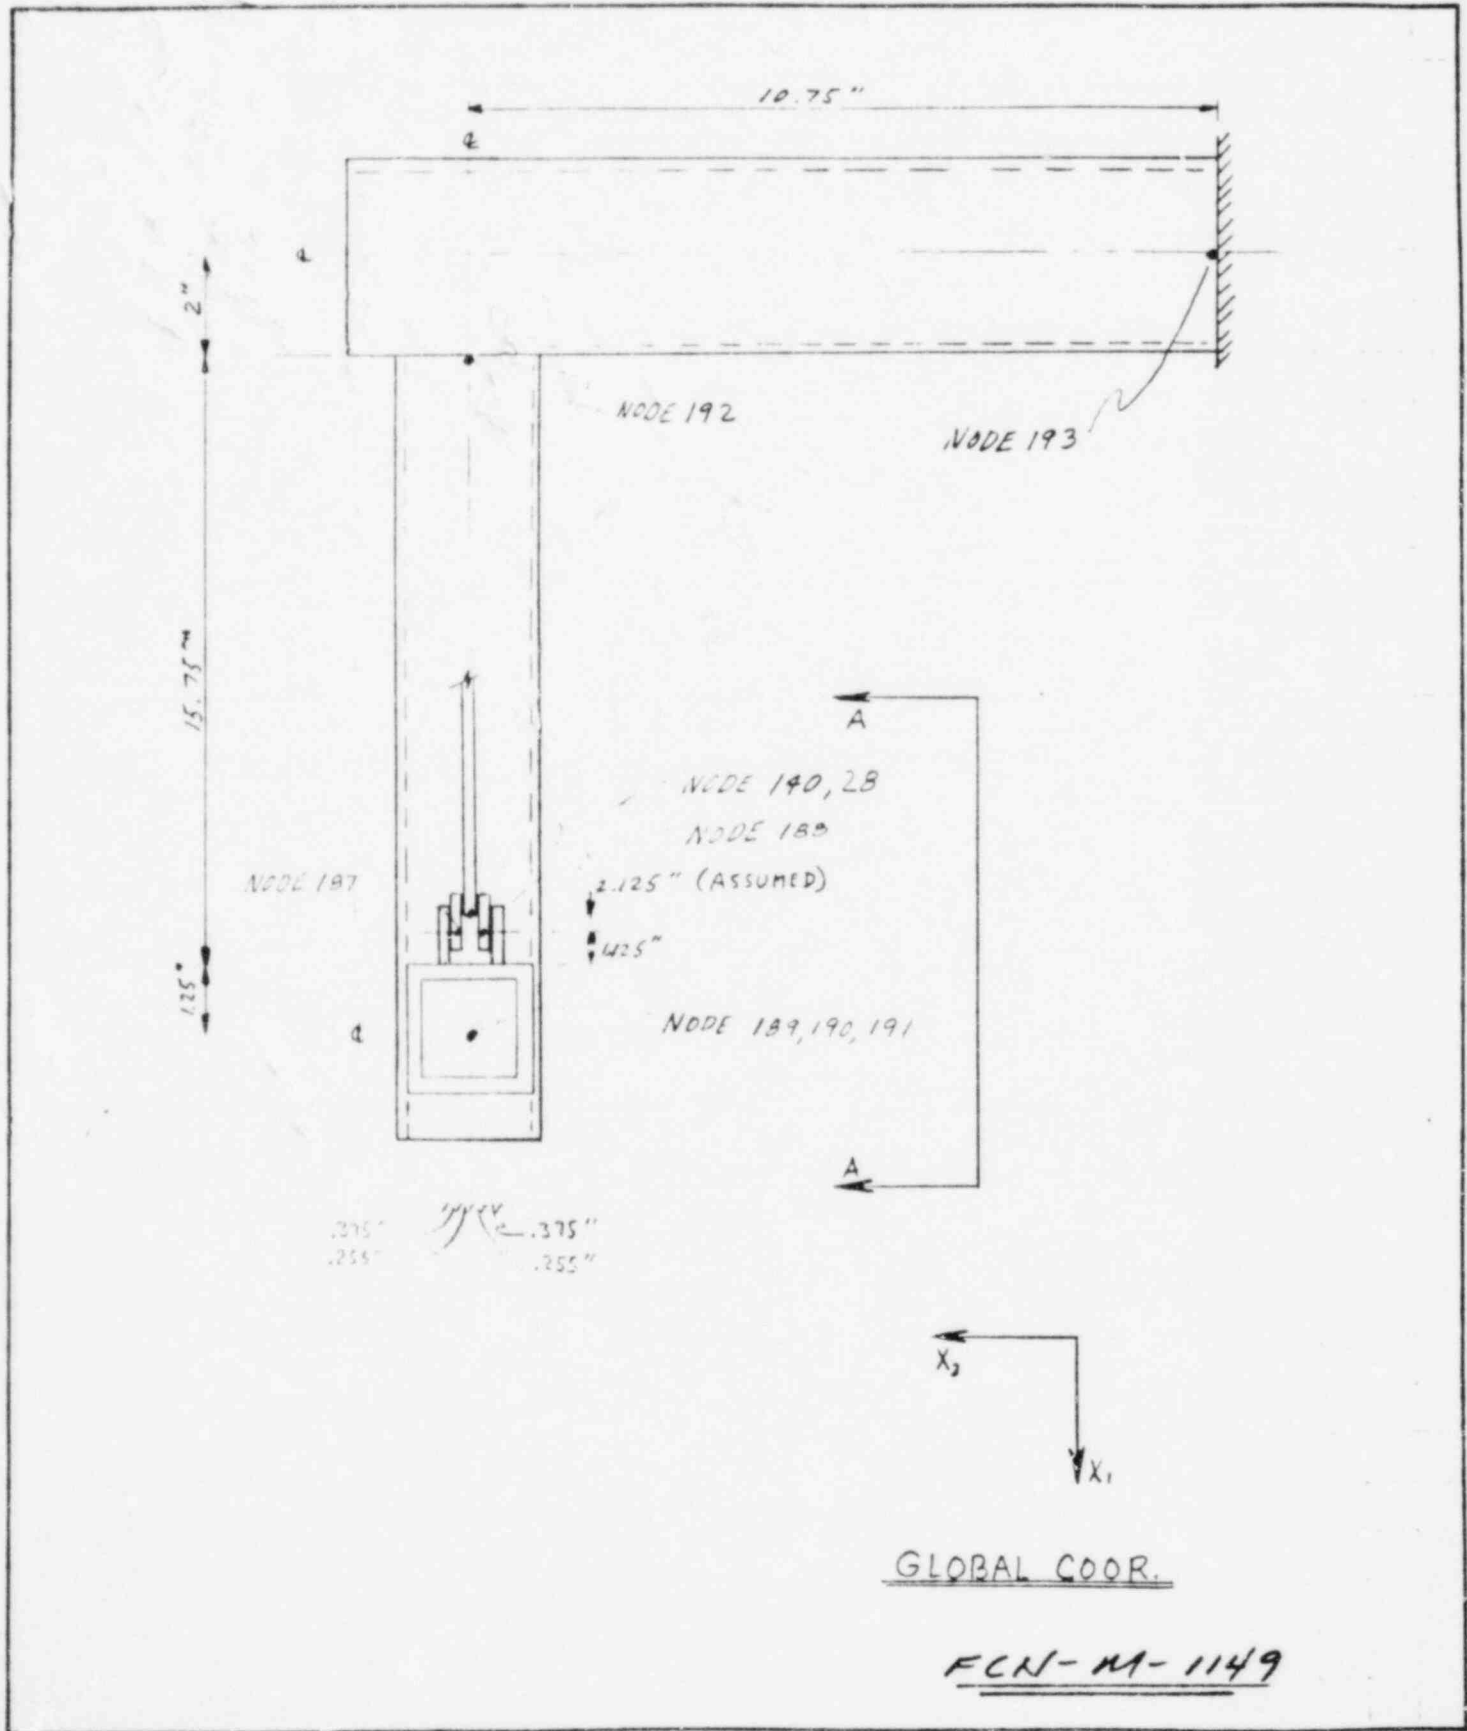

GLOBAL COOR.

FCN-M-1149



N/A

CHANGE REQUEST/NOTICE

NO



JOB NO. 9645

BRN# FCM-1141  
PAGE 1 OF 2

REF. DESG. OR SPEC. NO. 645-A-6172-03-11-1101 REV. 1 TITLE Safety Related

REASON FOR CHANGE/EXISTING CONDITION Automatic Control Damper

Add support to existing solenoid mounting plate on actuator Q2277503B.

CHANGE REQUEST/SKETCH (IF NECESSARY)

As-Built

See page 2

ATTACHMENT; 4, 1 OF 2

FOR INFORMATION ONLY Date: 3/10/02



WPAR# Q22776003C

PFE APPROVED FOR - SUBMIT TO PROJECT ENGR   
PFE APPROVED FOR - PROCEED WITH WORK   
PFE DISAPPROVED   
PFE: [Signature] DATE 2/8/02

PREPARED BY: [Signature] DATE 1/5/02

ACTION BY ENGINEERING - DESCRIPTION OF CHANGE ..

THIS IS: DCN # \_\_\_\_\_  
TO DWG # \_\_\_\_\_ REV. \_\_\_\_\_  
SCN # \_\_\_\_\_  
TO SPEC. # \_\_\_\_\_ REV. \_\_\_\_\_  
DEVIATION # D  
DATE \_\_\_\_\_  
PAGE \_\_\_\_\_ OF \_\_\_\_\_

REMARKS \_\_\_\_\_ RESP. ENGR: \_\_\_\_\_ DATE \_\_\_\_\_ CHKD: \_\_\_\_\_

GROUP SUPV. \_\_\_\_\_ DATE \_\_\_\_\_

CHIEF ENGINEER \_\_\_\_\_ DATE \_\_\_\_\_ PROJECT ENGR. APPROVAL YES  NO

BAR CHANGES YES  NO  CDT \_\_\_\_\_ DATE \_\_\_\_\_

TO: C. D. Wood cc: L. F. Dale; C. K. McCoy; T. E. Reese; File: 0080

8

FOR INFORMATION ONLY Date: 3/10/82


SUPPLEMENTAL SHEET  
CHANGE REQUEST/NOTICE

ECN-  
CHG No. M-1141

PAGE 2 OF 2


ATTACHMENT; H, 2 OF 2

Existing 4x4x3/8 41 AC Supp  
Supports DEZ 7-2-82 HOI

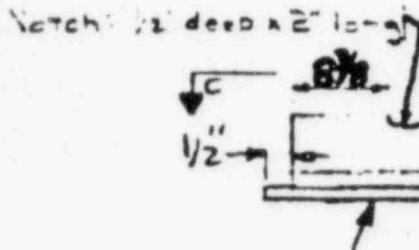


Scandoid Mounting Pt

PLAN VIEW

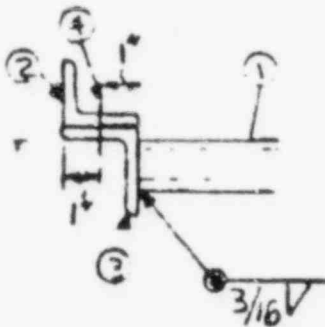

SECTION A-A

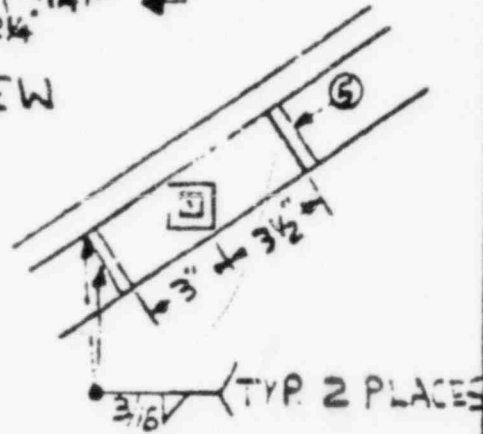

SECTION B-B

2 Notches as indicated  
1/2" deep x 3/4" Long




SECTION C-C

BILL OF MATERIALS

ITEM # DESCRIPTION

1	TS 2x2x1/4 - 6' long
2	1 1/2x2x1/4 - 19 7/8
3	K 2-3 1/4 x 5
4	2- 3/16 holes
5	2- 3/2 x 3/2 x 1/2 (2 total)

2- 1/2 x 1 1/2 Long A-307 Bolts

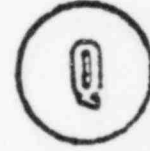

9



# CALCULATION SHEET



JOB NO. 9645 CALC. NO. Q1277, Q2277 REV. NO. A

PROJECT MISSISSIPPI POWER & LIGHT COMPANY BY Ray Mittie DATE 2-17-82

SUBJECT GRAND GULF NUCLEAR STATION CKD Stephen A. Descoteaux DATE 2/26/82

SOLENOID MOUNTING PLATE SHEET NO. 13 OF 95

FCN-M-1141

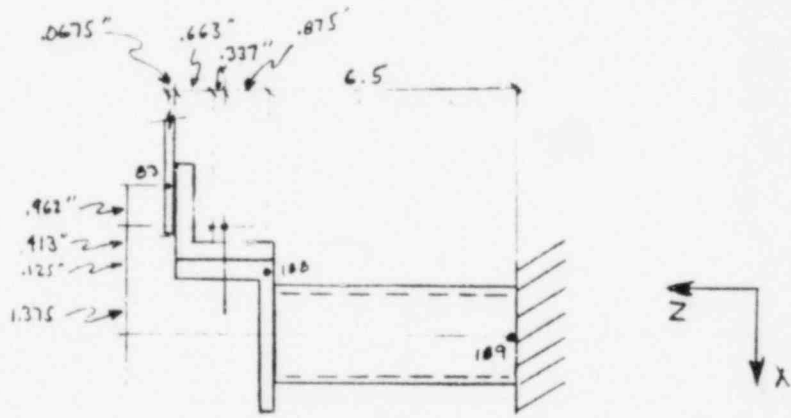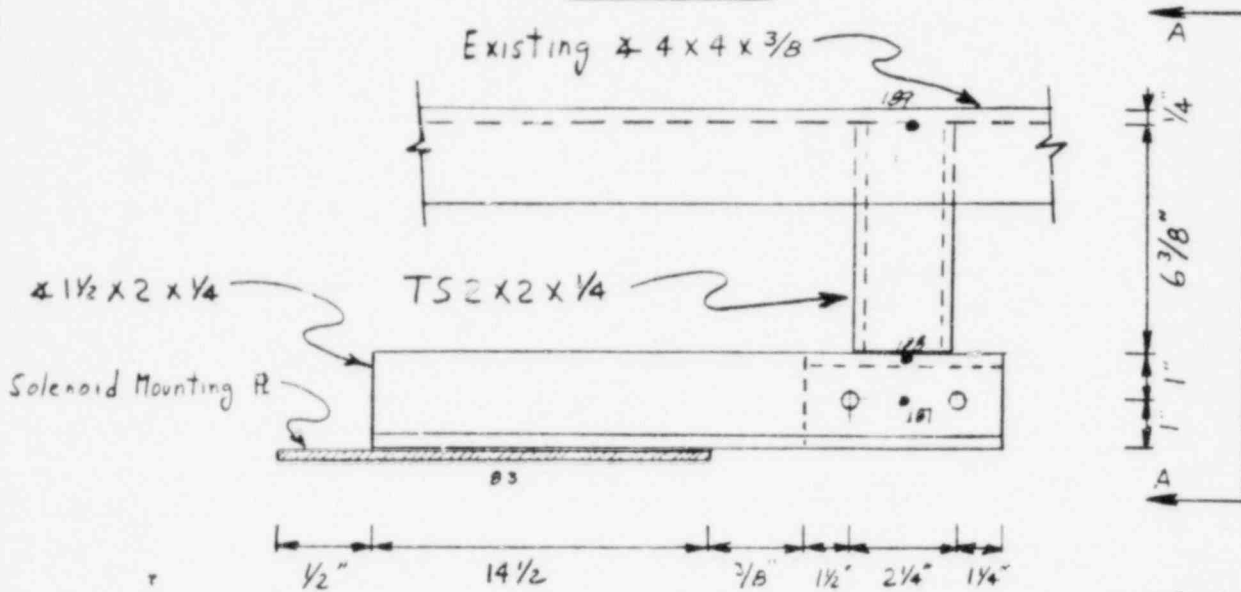

SECTION A-A

FROM D.P.	TO D.P.	SECTION
83	187	4 1/2 x 2 x 1/4
187	188	SOLID RECTANGLE 5 x 1/4
188	189	TS 2 x 2 x 1/4



MPL # N/A

CHANGE REQUEST/NOTICE

08  
100



JOB NO. 9648

DRW NO. ENR-M-1140  
PAGE 1 OF 2

REF. Dwg. OR SPEC. NO. 245-M-6171-06-11-6-5 REV. 5 TITLE Safety Related

REASON FOR CHANGE/EXISTING CONDITION Automatic Control Cumpers.

All support to station solenoid mounting plates on  
actuators Q22715001A.

CHANGE REQUEST/SKETCH (IF NECESSARY)

As-Built

See page 2

ATTACHMENT; I, 1 OF 2

FOR INFORMATION ONLY Date: 3/10/82

WP# Q22716002-c

PFE APPROVED FOR - SUBMIT TO PROJECT ENGR.   
PFE APPROVED FOR - PROCEED WITH WORK   
PFE DISAPPROVED   
PFE: R. H. Haden DATE 2/5/82

PREPARED BY: Danny Palmer DATE 1/15/82

ACTION BY ENGINEERING - DESCRIPTION OF CHANGE ..

THIS IS: DCN # \_\_\_\_\_  
TO DWG # \_\_\_\_\_ REV. \_\_\_\_\_  
SON # \_\_\_\_\_  
TO SPEC # \_\_\_\_\_ REV. \_\_\_\_\_  
DEVIATION # ① \_\_\_\_\_  
DATE \_\_\_\_\_  
PAGE \_\_\_\_\_ OF \_\_\_\_\_

REMARKS \_\_\_\_\_ RESP. ENGR: \_\_\_\_\_ DATE \_\_\_\_\_ CHKD: \_\_\_\_\_

GROUP SUPV. \_\_\_\_\_ DATE \_\_\_\_\_

CHIEF ENGINEER \_\_\_\_\_ DATE \_\_\_\_\_ PROJECT ENGR. APPROVAL YES  NO

BAR CHANGES YES  NO  COT - \_\_\_\_\_ DATE \_\_\_\_\_

TO: C. D. Wood ac: L. F. Dale; C. K. McCoy; T. E. Reeves File: 00801

3



FOR INFORMATION ONLY Date: 3/10/02



SUPPLEMENTAL SHEET  
CHANGE REQUEST/NOTICE

FCN: GR. # 10 M-1140

PAGE 2 OF 2

ATTACHMENT; I, 2 OF 2

Existing 6" x 6" x 3/8" HVAC Support Q2 Z77G003 H19

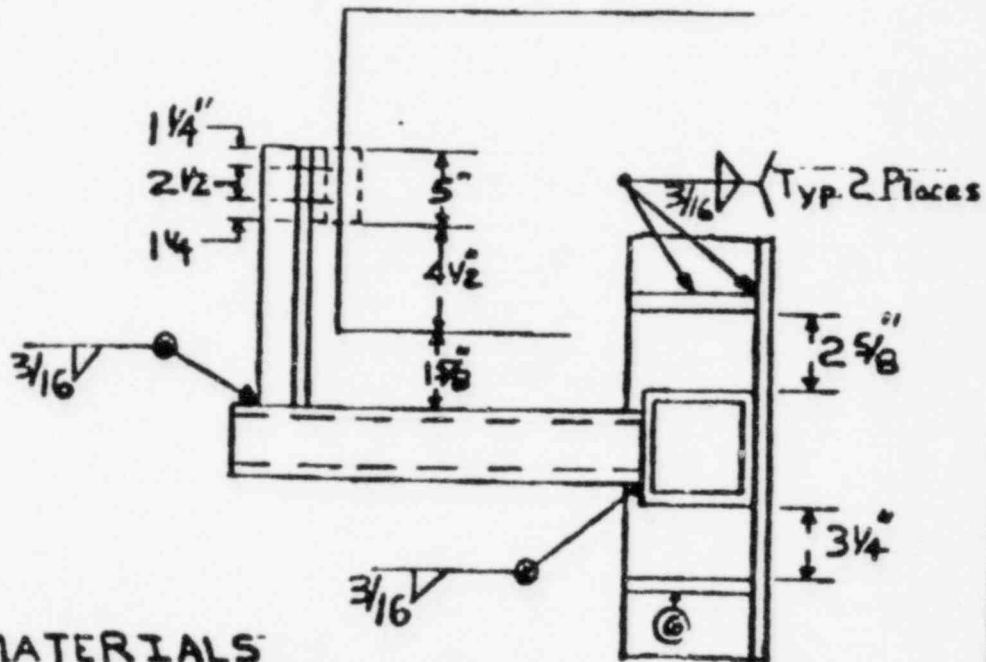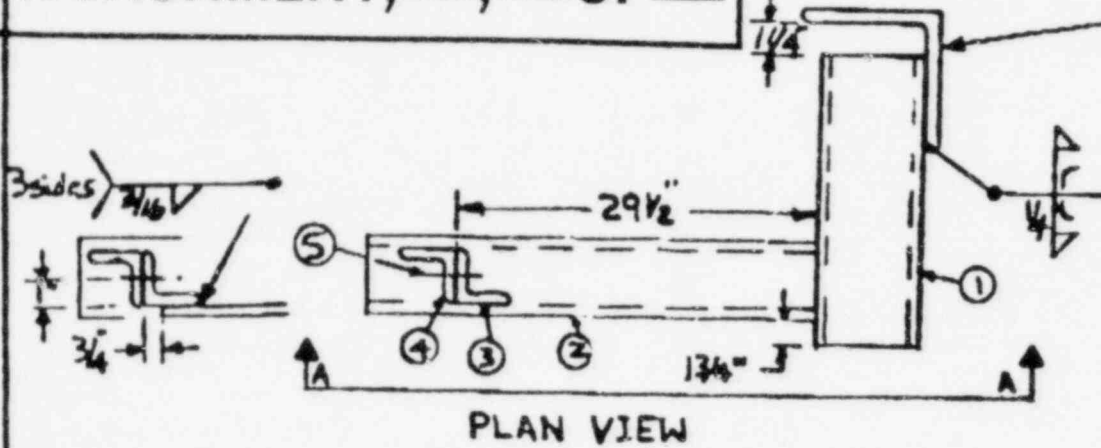

BILL OF MATERIALS

ITEM #	DESCRIPTION
1	TS 4" x 4" x 1/4" x 9" Long
2	TS 3" x 3" x 1/4" x 29 3/4" Long
3	* 2" x 2" x 1/4" x 5" Long
4	* 2" x 2" x 1/4" x 11 1/4" Long
5	2 - 9/16" $\phi$ holes for 1/2" $\phi$ A307 Bolts W/NUTS
6	R 5 1/2" x 5 1/2" x 1/2" (2 total)





NIA

CHANGE REQUEST/NOTICE 03

JOB NO. 8645

CR. NO. FEN-M-1143

PAGE 1 OF 2



REF. DWG OR SPEC. NO. WPAR-6175-Q3-1.1-6-5 REV. 5

TITLE Safety Related

REASON FOR CHANGE/EXISTING CONDITION

Automatic Control Ramps

Add support to existing solenoid mounting plate on actuator Q22776003A.

CHANGE REQUEST/SKETCH (IF NECESSARY)

As-Built

See page 2

ATTACHMENT; J, 1 OF 2

FOR INFORMATION ONLY Date: 3/10/02



WPAR # Q22776003-C

PREPARED BY [Signature] DATE 1/5/02

PFE APPROVED FOR - SUBMIT TO PROJECT ENGR.   
PFE APPROVED FOR - PROCEED WITH WORK   
PFE DISAPPROVED   
PFE: [Signature] DATE 2/5/02

ACTION BY ENGINEERING - DESCRIPTION OF CHANGE --

THIS IS: DCN # \_\_\_\_\_  
TO DWG # \_\_\_\_\_ REV. \_\_\_\_\_  
SCH # \_\_\_\_\_  
TO SPEC # \_\_\_\_\_ REV. \_\_\_\_\_  
DEVIATION # D \_\_\_\_\_  
DATE \_\_\_\_\_  
PAGE \_\_\_\_\_ OF \_\_\_\_\_

REMARKS \_\_\_\_\_

RESP. ENGR: \_\_\_\_\_ DATE \_\_\_\_\_ CHKD: \_\_\_\_\_

GROUP SUPV. \_\_\_\_\_ DATE \_\_\_\_\_

CHIEF ENGINEER \_\_\_\_\_ DATE \_\_\_\_\_

PROJECT ENGR. APPROVAL YES  NO

SAR CHANGES YES  NO


CDT - \_\_\_\_\_ DATE \_\_\_\_\_

TO: C. D. Wood cc: L. F. Dale; C. K. McCo; T. E. Rojas

FAs: 0080V \_\_\_\_\_ DATE \_\_\_\_\_

SUPPLEMENTAL SHEET  
CHANGE REQUEST/NOTICE


FCN-  
CR/N No. M-1143  
PAGE 2 OF 2

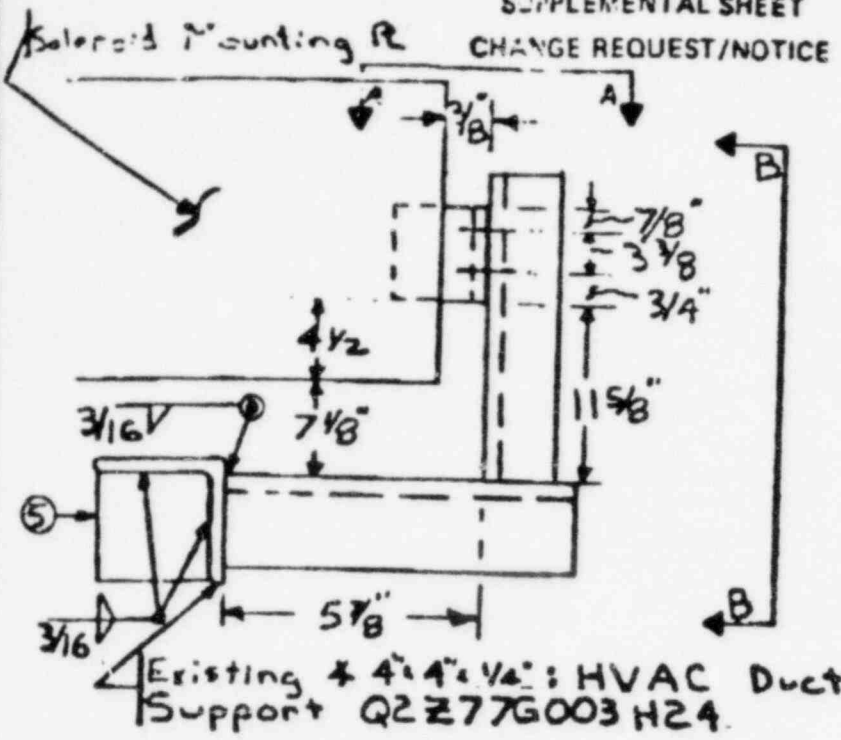

SECTION A-A

ATTACHMENT; J, 2 OF 2

FOR INFORMATION ONLY Date: 3/10/82

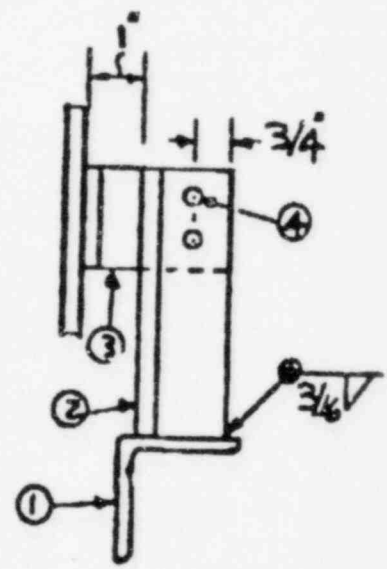

SECTION B-B

BILL OF MATERIALS

ITEM #	DESCRIPTION
1	X 3" x 3" x 1/4" x 9" Long
2	X 2" x 2" x 1/4" x 16 3/4" Long
3	X 1 1/2" x 3" x 1/4" x 5" Long
4	2- 9/16" Ø holes for 1/2" Ø A307 Bolts W/ Nuts
5	R 3 1/4" x 3 1/4" x 3/8"



# CALCULATION SHEET

JOB NO. 9645

CALC. NO. Q1277, Q2277 REV. NO. A

PROJECT MISSISSIPPI POWER & LIGHT COMPANY

BY [Signature] DATE 3/8/82


SUBJECT GRAND GULF NUCLEAR STATION

CKD Stephen A. Deschamps DATE 3/10/82


SOLENOID MOUNTING PLATE

SHEET NO. 15 OF 95

FCN-M-1143

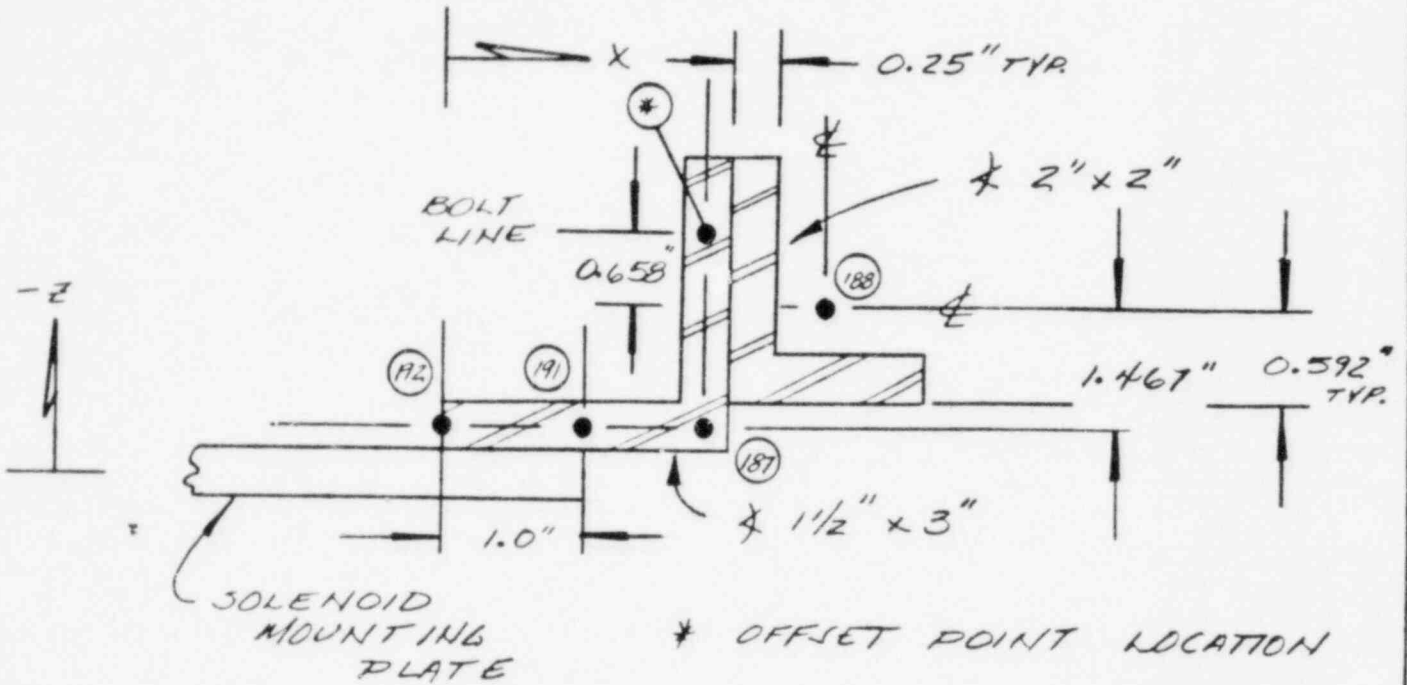

PLAN VIEW

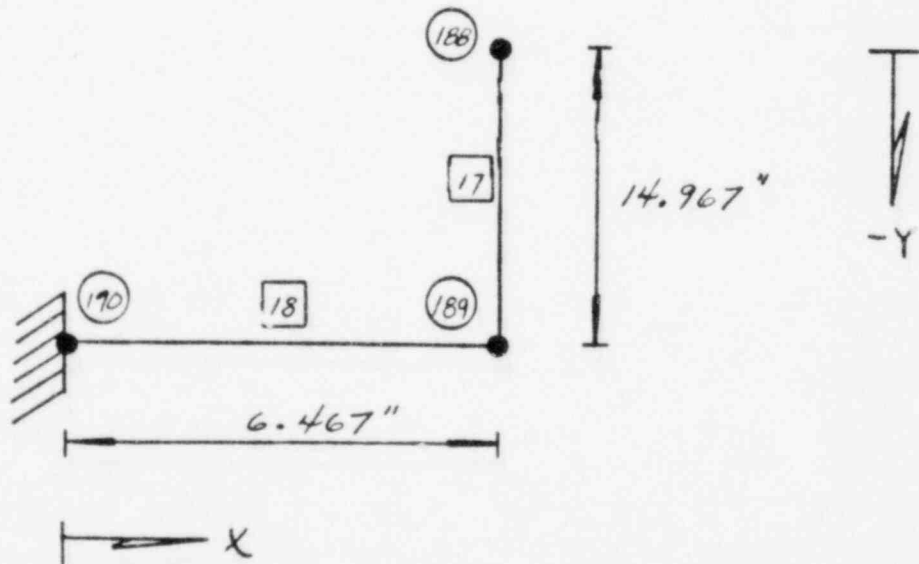



# CALCULATION SHEET

JOB NO. 9645

CALC NO. Q1277, Q2277 REV. NO. A

PROJECT MISSISSIPPI POWER & LIGHT COMPANY

BY [Signature] DATE 3/10/82


SUBJECT GRAND GULF NUCLEAR STATION

CKD Stephen A. Descoteaux DATE 3/10/82

SOLENOID MOUNTING PLATE SHEET NO. 16 OF 95

FCN-41-1143

(CONT.)

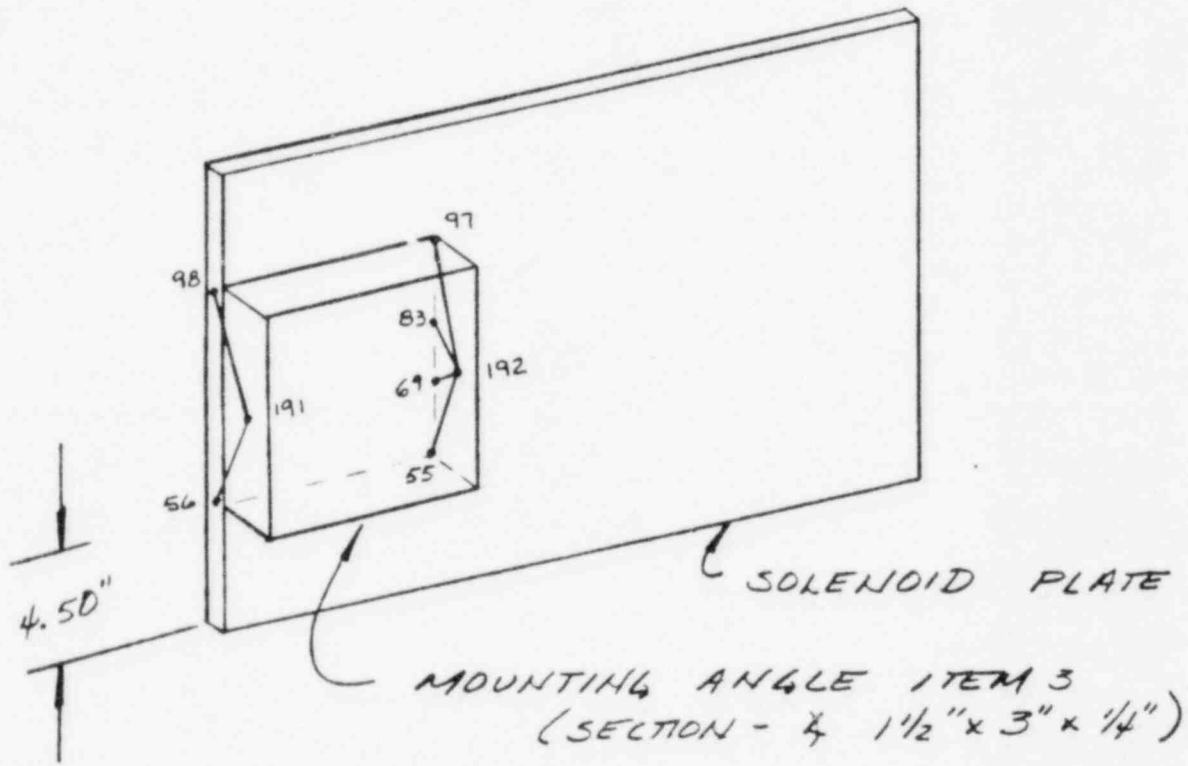

NODAL POINT CONFIGURATION



# CALCULATION SHEET

JOB NO. 9645CALC. NO. Q1277, Q2277REV. NO. APROJECT MISSISSIPPI POWER & LIGH COMPANYBY Stephen A. DescoteauxDATE 3/10/82SUBJECT GRAND GULF NUCLEAR STATIONCKD James H. KellyDATE 3/10/82SOLENOID MOUNTING PLATESHEET NO. 17 OF 95

REACTIONS AT CONNECTION OF SUPPORT STRUCTURE  
TO HVAC DUCT EXISTING MEMBER FOR FCN-M-1143

ANCHOR POINT IS AT NODE 190, END OF MEMBER 18; DEAD LOAD  
AND SEISMIC LOAD EFFECTS MUST BE ADDED:

DEAD LOAD (SEE EQUILIBRIUM CHECK OF STATIC RUN)

$F_{x1}$	$F_{x2}$	$F_{x3}$	$M_{x1}$	$M_{x2}$	$M_{x3}$
0.9#	1.8#	0.3#	6.4" #	0.5" #	19.1" #

DYNRE 4 (SEE BEAM END LOADS AT NODE 190, BEAM ELEMENT NO. 18)

$F_{x1}$	$F_{x2}$	$F_{x3}$	$M_{x1}$	$M_{x2}$	$M_{x3}$
4.3 #	38.9 #	5.3 #	22.5" #	27.8" #	166.9" #

TOTAL

$F_{x1}$	$F_{x2}$	$F_{x3}$	$M_{x1}$	$M_{x2}$	$M_{x3}$
5 #	41 #	6 #	29" #	28" #	186" #



# CALCULATION SHEET

JOB NO. 9645  
 PROJECT MISSISSIPPI POWER & LIGHT COMPANY  
 SUBJECT GRAND GULF NUCLEAR STATION  
SOLENOID MOUNTING PLATE

CALC. NO. Q1277, Q2277 REV. NO. A  
 BY Stephen A. Descoteaux DATE 3/10/82  
 CKD James H. Callahan DATE 3/10/82  
 SHEET NO. 18 OF 95

MAXIMUM QUADRILATERAL PLATE STRESSES FOR FCN-M-1143

DEAD LOAD AND SEISMIC LOAD EFFECTS MUST BE COMBINED:

DEAD LOAD (SEE MAXIMUM SURFACE STRESS SUMMARY FOR QUADRILATERAL STRESSES IN STATIC RUN)

MAXIMUM QUAD. # STRESS = 1225.5 PSI @ QUAD. # NO. 69

SEISMIC LOAD (SEE MAXIMUM RESPONSES SECTION OF QUAD.-PLATE STRESSES ON DYNRE 4 RUN)

THE FOLLOWING MAXIMUM SURFACE STRESSES ARE LISTED:

+Z FACE	[	$S_x = 1794.9 \text{ PSI}$ $S_y = 1900.0 \text{ PSI}$ $S_{xy} = 722.7 \text{ PSI}$	-	Z FACE	[	$S_x = 1280.1 \text{ PSI}$ $S_y = 1169.4 \text{ PSI}$ $S_{xy} = 444.7 \text{ PSI}$
---------	---	------------------------------------------------------------------------------------------	---	--------	---	------------------------------------------------------------------------------------------

(ALL VALUES @ QUAD. # NO. 69 EXCEPT 444.7 PSI)

$$\text{PRINCIPAL STRESSES: MAX.} = \frac{S_x + S_y}{2} + \sqrt{\left(\frac{S_x - S_y}{2}\right)^2 + (S_{xy})^2}$$

$$\text{MIN.} = \frac{S_x + S_y}{2} - \sqrt{\left(\frac{S_x - S_y}{2}\right)^2 + (S_{xy})^2}$$

TAKE ABSOLUTE MAX. PRINCIPAL STRESS AT BOTH FACES:

$$+Z \text{ FACE} \Rightarrow \text{MAX. PRIN. STRESS} = \frac{1794.9 + 1900.0}{2} + \sqrt{\left(\frac{1794.9 - 1900.0}{2}\right)^2 + (722.7)^2}$$

$$-Z \text{ FACE} \Rightarrow \text{MAX. PRIN. STRESS} = \frac{1280.1 + 1169.4}{2} + \sqrt{\left(\frac{1280.1 - 1169.4}{2}\right)^2 + (444.7)^2}$$

+Z FACE IS WORST CASE: MAX. PRINCIPAL STRESS = 3831.2 PSI

TOTAL MAXIMUM QUADRILATERAL PLATE STRESS = 1225.5 + 3831.2 = 5057 PSI





# CALCULATION SHEET

JOB NO. 9645  
PROJECT MISSISSIPPI POWER & LIGHT COMPANY  
SUBJECT GRAND GULF NUCLEAR STATION  
SOLENOID MOUNTING PLATE

CALC NO. Q1277, Q2277 REV. NO. A  
BY Stephen A. Descoteaux DATE 3/10/82  
CKD James R. Calhoun DATE 3/10/82  
SHEET NO. 19 OF 95

MAXIMUM BEAM STRESS FOR FCN-M-1143

DEAD LOAD AND SEISMIC LOAD EFFECTS MUST BE COMBINED:

DEAD LOAD (SEE STATIC RUN BEAM STRESS SUMMARY)

MAX. COMBINED AXIAL AND BENDING STRESS = 91.63 PSI  
AT MEMBER 17

MAX. COMBINED SHEAR STRESS ( $f_{v2} + f_{v3} + T$ ) = 185.66 PSI  
MAX. SUM OF  
ALL MEMBERS

SEISMIC LOAD (TAKE MAXIMUM VALUES FROM DYNRE4 RUN)

MAX. COMBINED AXIAL AND BENDING STRESS = 605.36 PSI (MEM. 17)

MAX. COMBINED SHEAR STRESS = 264.122 PSI (MEM. 18)

TOTAL: MAX. COMBINED AXIAL AND BENDING STRESS = 696.99 PSI \*

MAX. COMBINED SHEAR STRESS = 452.16 PSI

\* WORST BEAM STRESS



# CALCULATION SHEET

JOB NO. 9645CALC. NO. Q1277, Q2277 REV. NO. APROJECT MISSISSIPPI POWER & LIGHT COMPANYBY Stephen A. Descoteaux DATE 3/10/82SUBJECT GRAND GULF NUCLEAR STATIONCKD James H. [Signature] DATE 3/10/82SOLENOID MOUNTING PLATESHEET NO. 20 OF 95

## MAXIMUM BEAM LOADS FOR FCN-M-1143

DEAD LOAD AND SEISMIC LOAD EFFECTS MUST BE COMBINED:

DEAD LOAD (SEE STATIC RUN BEAM ELEMENT LOADS SUMMARY)

MAXIMUM BEAM LOADS	P	V <sub>2</sub>	V <sub>3</sub>	M <sub>T</sub>	M <sub>2</sub>	M <sub>3</sub>
	5.2#	11.0#	3.6#	17.7" #	15.3" #	19.1" #

SEISMIC LOAD (SEE MAXIMUM BEAM END LOADS ON DYNRE4 RUN)

MAXIMUM BEAM LOADS	P	V <sub>2</sub>	V <sub>3</sub>	M <sub>T</sub>	M <sub>2</sub>	M <sub>3</sub>
	38.9#	39.1#	9.6#	22.5" #	82.8" #	145.9" #

TOTAL MAXIMUM BEAM LOADS:

P	V <sub>2</sub>	V <sub>3</sub>	M <sub>T</sub>	M <sub>2</sub>	M <sub>3</sub>
44#	50#	13#	40" #	98" #	185" #

UPL # N/A

CHANGE REQUEST/NOTICE

02  
100



JOB NO. 9648

ORIG: FCN-M-1145

PAGE 1 OF 7

REF: OR SPEC. NO. 445-M-11-6-5 REV. 5 TITLE Safety Related

REASON FOR CHANGE/EXISTING CONDITION: Automate Control Ramp

Support to stiffer solenoid mounting plate on  
Q2277502A

CHANGE REQUEST/SKETCH (IF NECESSARY)

As-Built

See page 2

ATTACHMENT; K, 1 OF 2

FOR INFORMATION ONLY Date: 3/10/02



WPART Q2277003-C

PREPARED BY: [Signature] DATE 1/15/02

PFE APPROVED FOR - SUBMIT TO PROJECT ENGR.   
PFE APPROVED FOR - PROCEED WITH WORK   
PFE DISAPPROVED   
PFE: [Signature] DATE 2/7/02

ACTION BY ENGINEERING - DESCRIPTION OF CHANGE --

THIS IS: DCN # \_\_\_\_\_  
TO DWG # \_\_\_\_\_ REV. \_\_\_\_\_  
SON # \_\_\_\_\_  
TO SPEC # \_\_\_\_\_ REV. \_\_\_\_\_  
DEVIATION # D \_\_\_\_\_  
DATE \_\_\_\_\_  
PAGE \_\_\_\_\_ OF \_\_\_\_\_

REMARKS \_\_\_\_\_

RESP. ENGR: \_\_\_\_\_ DATE \_\_\_\_\_ CHKD: \_\_\_\_\_

CHIEF ENGINEER \_\_\_\_\_ DATE \_\_\_\_\_

GROUP SUPV. \_\_\_\_\_ DATE \_\_\_\_\_

PROJECT ENGR. APPROVAL YES  NO



SAR CHANGES YES  NO

COT - \_\_\_\_\_ DATE \_\_\_\_\_

TO: C. D. Wood cc: L. F. Dale; C. K. McCoy; T. E. Reaves File: 0080/

See next page (5)

Existing 4' x 4' 3/8" HVAC Duct  
Support Q2 Z775003 H12

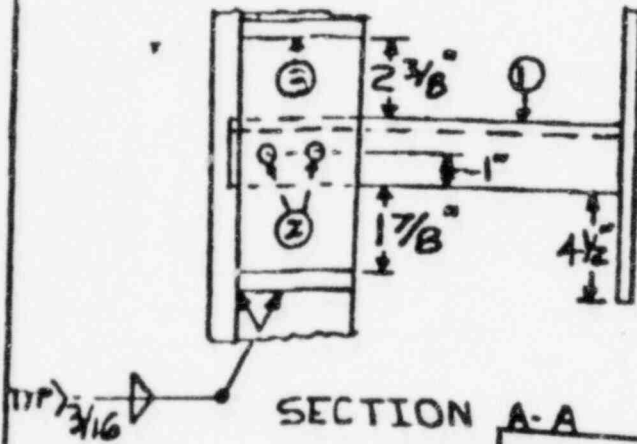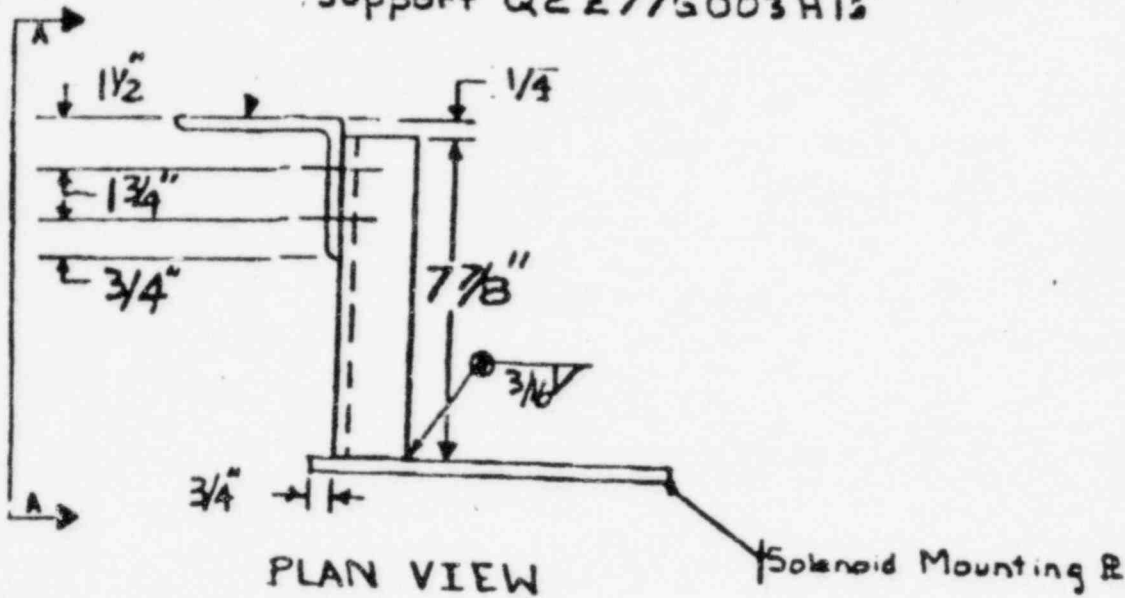

FOR INFORMATION  
ONLY Date: 3/10/82

ATTACHMENT; K, 2 OF 2

BILL OF MATERIALS

ITEM#	DESCRIPTION
1	2' x 2' x 1/4" x 7 7/8" Long
2	2- 9/16" Ø holes for 1/2" Ø A307 Bolts
3	R 3 1/2" x 3 1/2" x 3/8" (2 total)





# CALCULATION SHEET

JOB NO. 9645

CALC. NO. Q1277, Q2277

REV. NO. A

PROJECT MISSISSIPPI POWER & LIGHT COMPANY

BY [Signature]

DATE 3/8/82

SUBJECT GRAND GULF NUCLEAR STATION



CKD [Signature]

DATE 3/9/82

SOLENOID MOUNTING PLATE

SHEET NO. 21 OF 95

FCN-M-1145

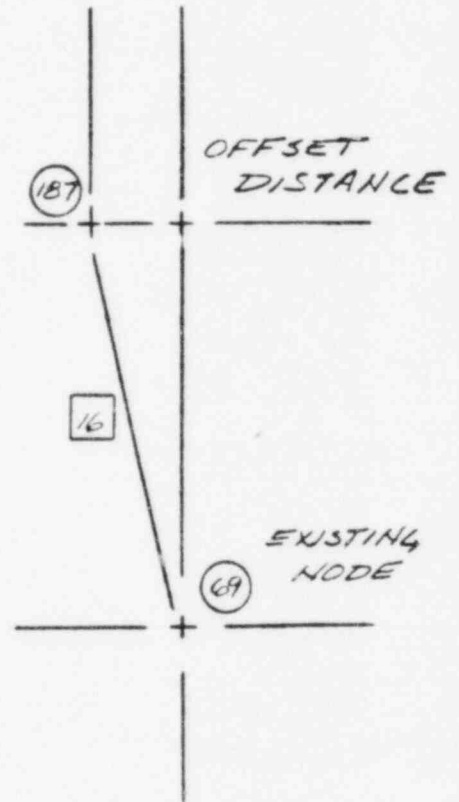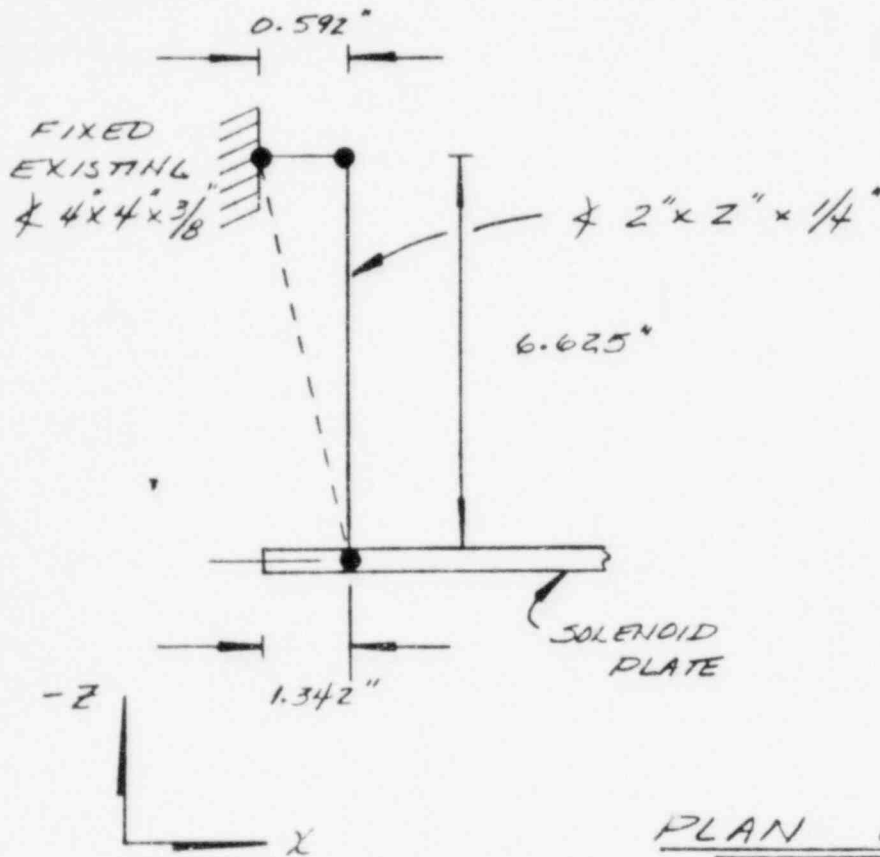

PLAN VIEWS

NOTE: RIGID BEAM ELEMENTS CODED BETWEEN NODES 68-69, AND 55-69 TO ACCOUNT FOR THE SHAPE OF THE 2" x 2" x 1/4" ANGLE WELDED TO THE SOLENOID PLATE.



MPL # N/A

CHANGE REQUEST/NOTICE



JOB NO. 9845

ORIG: ENR-1142  
PAGE 1 OF 2

REF. DWG. OR SPEC. NO. 91645-17-1-11-1 REV.

TITLE Safety Related

REASON FOR CHANGE/EXISTING CONDITION

Automatic Control Damage

Add support to clutter cleaned mounting plate on actuator Q1E77G030.

CHANGE REQUEST/SKETCH (IF NECESSARY)

As-Built

See page 2 -

ATTACHMENT; 4, 1 OF 2

FOR INFORMATION ONLY Date: 3/10/02



WP&R: Q1E77G003-C

PFE APPROVED FOR - SUBMIT TO PROJECT ENG.   
PFE APPROVED FOR - PROCEED WITH WORK   
PFE DISAPPROVED   
PFE: *[Signature]* DATE 2/10/02

PREPARED BY: *[Signature]* DATE 4/15/02

ACTION BY ENGINEERING - DESCRIPTION OF CHANGE --

THIS IS: DCN # \_\_\_\_\_  
TO DWG # \_\_\_\_\_ REV. \_\_\_\_\_  
SON # \_\_\_\_\_  
TO SPEC. # \_\_\_\_\_ REV. \_\_\_\_\_  
DEVIATION # D \_\_\_\_\_  
DATE \_\_\_\_\_  
PAGE \_\_\_\_\_ OF \_\_\_\_\_

REMARKS \_\_\_\_\_

RESP. ENGR: \_\_\_\_\_ DATE \_\_\_\_\_ CHKD: \_\_\_\_\_

CHIEF ENGINEER \_\_\_\_\_ DATE \_\_\_\_\_

GROUP SUPV. \_\_\_\_\_ DATE \_\_\_\_\_

PROJECT ENGR. APPROVAL YES  NO

BAR CHANGES YES  NO

CDT - \_\_\_\_\_ DATE \_\_\_\_\_

TO: C. D. Wood cc: L. F. Dale; C. K. McCoy; T. E. Reams File: 0080/




SUPPLEMENTAL SHEET  
CHANGE REQUEST/NOTICE

FCN-  
CRAN No. M-1142

PAGE 2 OF 2

ATTACHMENT; L, 2 OF 2

FOR INFORMATION  
ONLY Date: 3/16/82

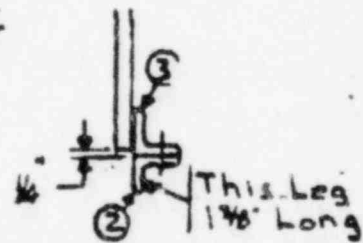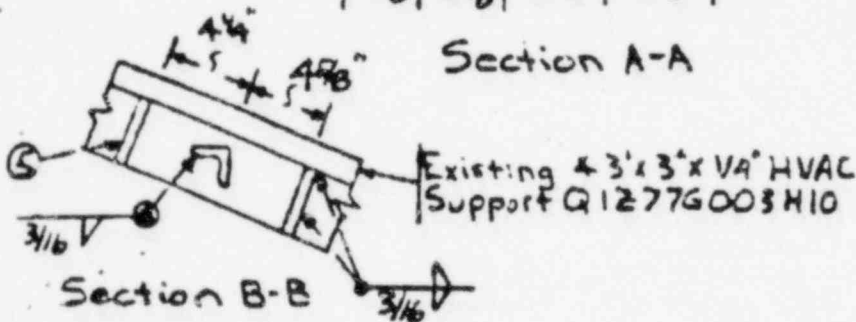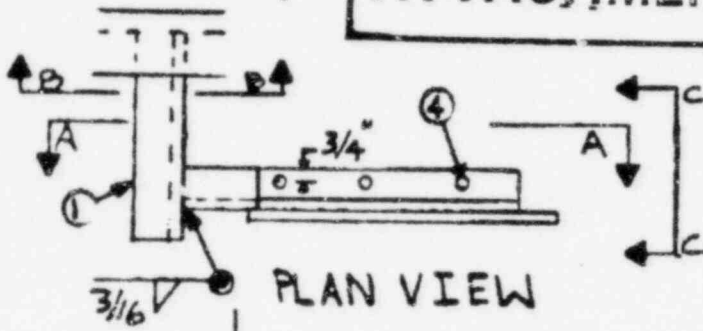

BILL OF MATERIALS

ITEM #	DESCRIPTION
1	4 2" x 2" x 1/4" x 6' Long
2	4 1 1/2" x 1 3/8" x 1/4" x 14 3/4" Long
3	4 1 1/2" x 1 1/2" x 1/4" x 9 3/8" Long
4	3- 9/16" Ø Bolt holes for 3- 1/2" Ø A 307 Bolts
5	2- R 2 1/2" x 2 1/2" x 3/8"





# CALCULATION SHEET

JOB NO. 9605

CALC. NO. Q1Z77, Q2Z77 REV. NO. A

PROJECT MISSISSIPPI POWER & LIGHT COMPANY

BY Vic. Nappo DATE FEB 23, 82


SUBJECT GRAND GULF NUCLEAR STATION

CKD Stephen A. Descoeur DATE 2/24/82

SOLENOID MOUNTING ID

SHEET NO. 22 OF 95

FCN-M-1142

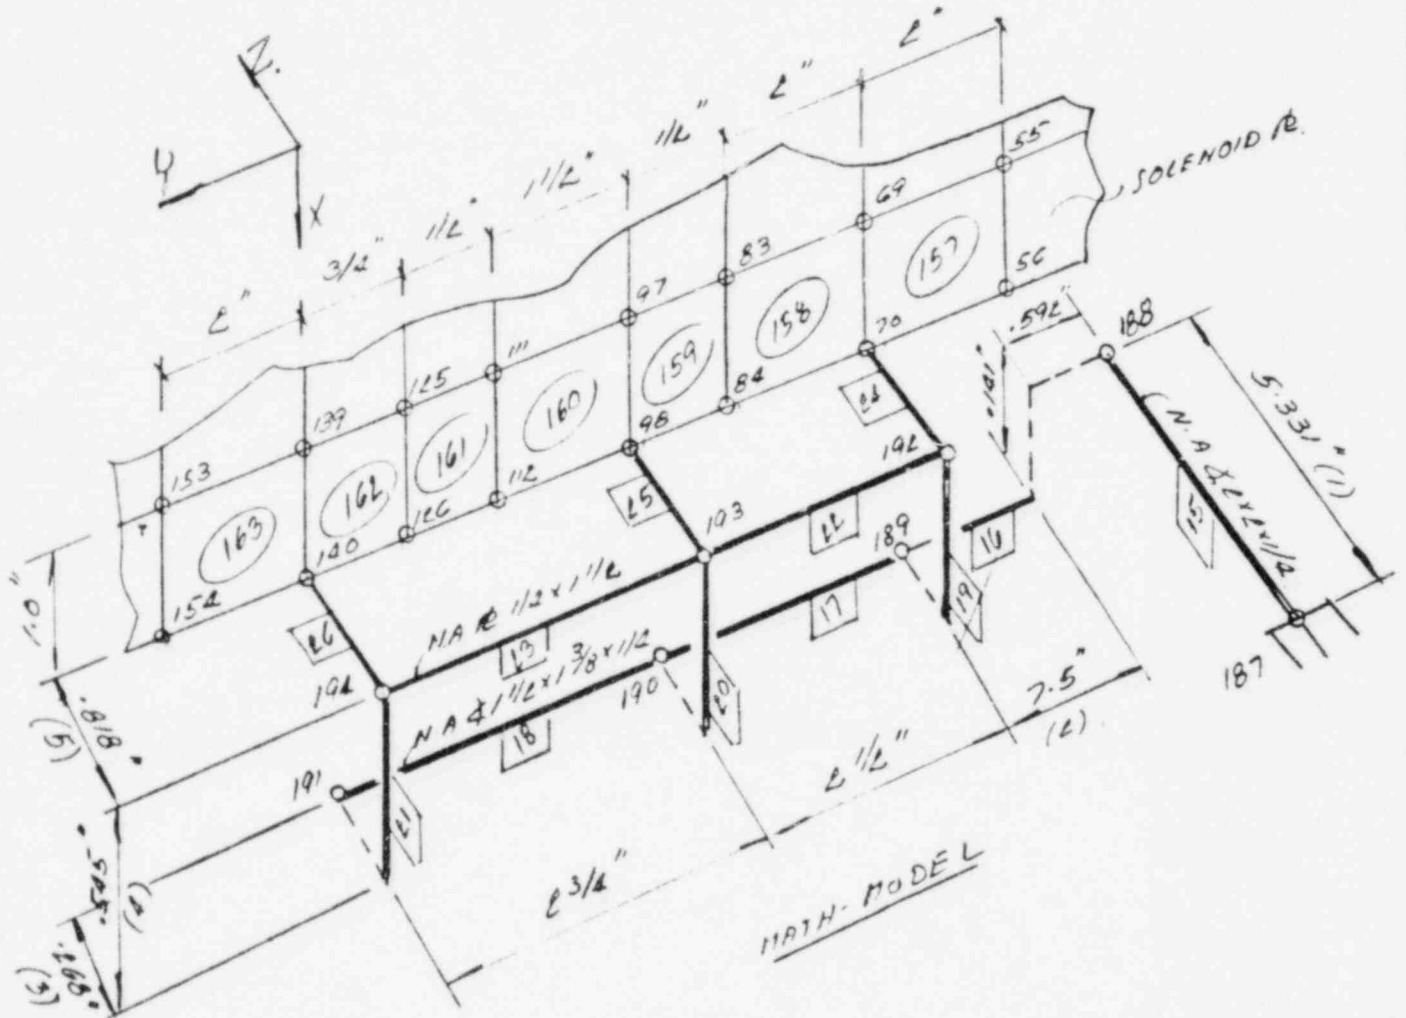

- (1) = LENGTH OF  $\Phi$  - SIZE OF WELD -  $\bar{x}$  OF TIEH 2  
 $= 6 - 3/16 - .482 = 5.331"$
- (2) = LENGTH OF TIEH 2 - DIST. FROM NODE 154 TO 70  
 $= 14.75 - 2 - 2.75 - 2.5 = 7.5"$
- (3) =  $3/4 - m$  (SEE  $m, n$  IN SECTION PROP)
- (4) =  $17 + \frac{.25}{2}$
- (5) =  $3/8 + \frac{.135}{2}$





# CALCULATION SHEET

JOB NO. 9685

CALC. NO. Q1Z77, Q2Z77 REV. NO. A

PROJECT MISSISSIPPI POWER & LIGHT COMPANY

BY U.S. CAMP. DATE FEB 23, 82

SUBJECT GRAND GULF NUCLEAR STATION

CKD Stephen A. Descoteaux DATE 2/24/82

SOLENOID MOUNTING R

SHEET NO. 23 OF 95

## ASSUMPTIONS:

- 1) ASSUME THAT BOLTS ARE AT NODES 192, 193, 194 WHICH JOIN SOLENOID MOUNTING R. @ NODE 70, 98, 100 RESPECTIVELY IN Z DIR. AND RIN CODED @ BOLTED NODES
- 2) ADD EXTRA 10  $4/10$ " DIAM TO SOLENOID MOUNTING R. I.E. 10 NO'S 157 - 163
- 3) TREAT MEM'S 22, 23 AS BEAMS  $4/10 \times 1/2$  SECTION.
- 4) ASSUME THAT  $\angle$  OF ANGLE LEGS OF ITEM 1 & OF ITEM 2 INTERSECT EACH OTHER ON SECTION A-A OF DESIGN SKETCH.
- 5) TREAT MEM'S 19, 20, 21 AS  $1/2 \times 1/8 \times 1/2$
- 6) TREAT MEM'S 24, 25, 26 AS 10  $1/2 \times 1/2$



MPL #

NIA

CHANGE REQUEST/NOTICE

Q8  
NO



JOB NO. 9645

BRW# ECN-M-1144

PAGE 1 OF 3

REF. DWG. OR SPEC. NO. 945-M-671-02-11-4-5 REV. 5

TITLE Safety Related

REASON FOR CHANGE/EXISTING CONDITION

Automatic Control Dampers

Add support to stiffen solenoid mounting plate on actuator Q1277603B.

CHANGE REQUEST/SKETCH (IF NECESSARY)

As-Built

See Pages 2 & 3

ATTACHMENT; M, 1 OF 3

FOR INFORMATION ONLY Date: 3/10/82



WPLR/Q1277603-C

MK

PREPARED BY: George Madry DATE 4/1/82

PFE APPROVED PCR - SUBMIT TO PROJECT ENGR.   
PFE APPROVED FCN - PROCEED WITH WORK   
PFE DISAPPROVED   
PFE: *[Signature]* DATE 2/9/82

ACTION BY ENGINEERING - DESCRIPTION OF CHANGE --

THIS IS: DCN # \_\_\_\_\_  
TO DWG # \_\_\_\_\_ REV. \_\_\_\_\_  
SCH # \_\_\_\_\_  
TO SPEC # \_\_\_\_\_ REV. \_\_\_\_\_  
DEVIATION # 0 \_\_\_\_\_  
DATE \_\_\_\_\_  
PAGE \_\_\_\_\_ OF \_\_\_\_\_

REMARKS \_\_\_\_\_

RESP. ENGR: \_\_\_\_\_ DATE \_\_\_\_\_ CHKD: \_\_\_\_\_

GROUP SUPV. \_\_\_\_\_ DATE \_\_\_\_\_

CHIEF ENGINEER \_\_\_\_\_ DATE \_\_\_\_\_

PROJECT ENGR. APPROVAL YES  NO

BAR CHANGES YES  NO

CDT - \_\_\_\_\_ DATE \_\_\_\_\_



TO: C. D. Wood as: L. F. Dale; C. K. McCoy; T. E. Reeves File: 0080/

SUPPLEMENTAL SHEET  
CHANGE REQUEST/NOTICE

FCN-  
DRAWING NO. M-1144

PAGE 2 OF 3

Existing 4" x 4" x 3/8" HVAC  
Support Q12776003 HIS

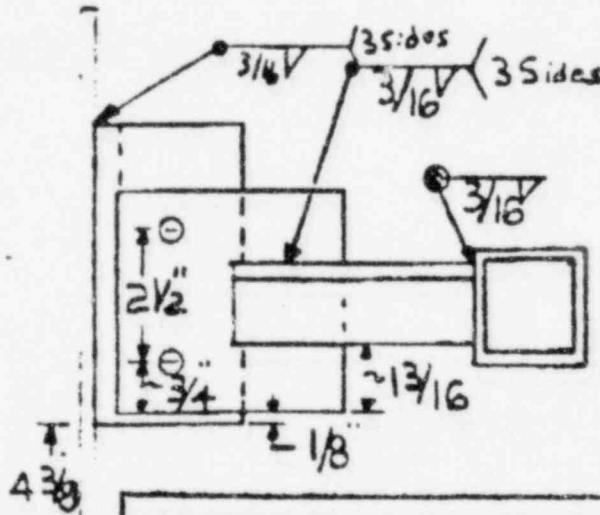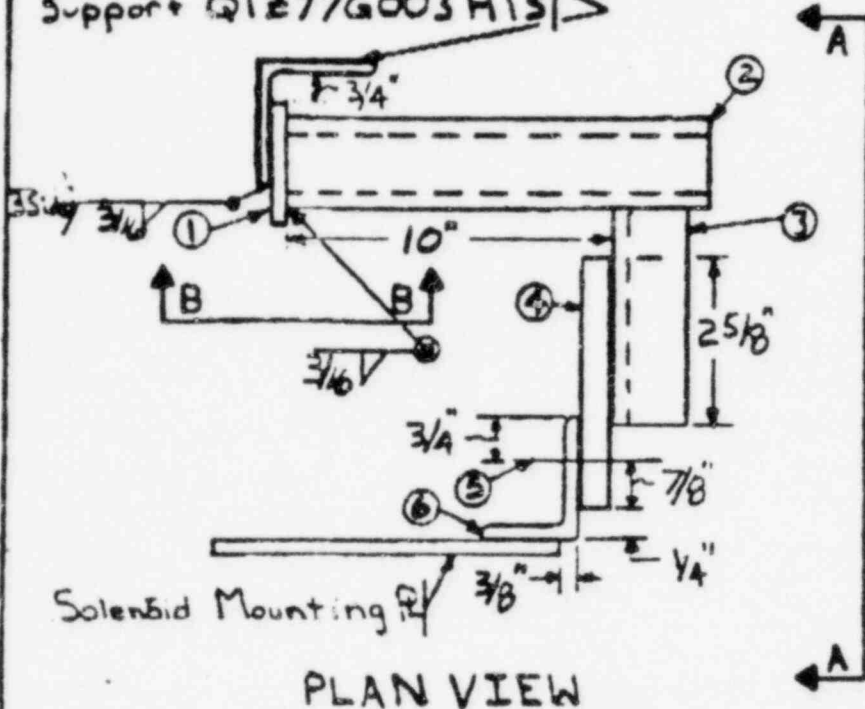

ATTACHMENT; M, 2 OF 3

Section A-A


FOR INFORMATION  
ONLY Date: 3/10/02



SUPPLEMENTAL SHEET  
CHANGE REQUEST/NOTICE

ECN No. M-1194

PAGE 3 OF 3

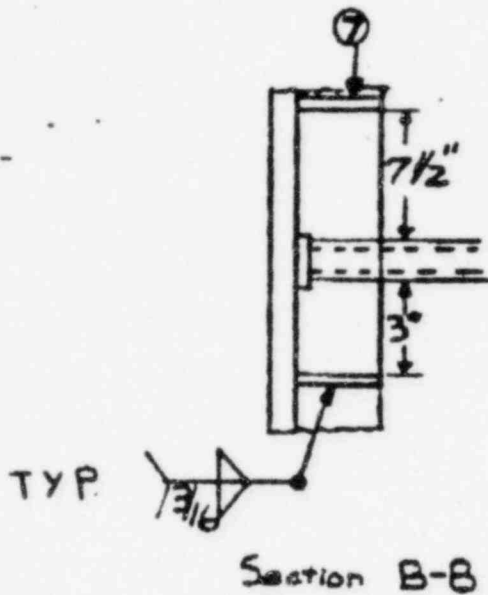

FOR INFORMATION  
ONLY Date: 3/10/82

ATTACHMENT; M, 3 OF 3

BILL OF MATERIALS

ITEM#	DESCRIPTION
1	R 3 1/2" x 3 1/2" x 1/2"
2	TS 2" x 2" x 1/4" x 14" Long
3	* 1 1/2" x 1 1/2" x 1/4" x 3 1/2" Long
4	Ø 4 3/16" x 4" x 3/8"
5	2- 9/16" Ø holes for 2- 1/2" Ø A307 Bolts
6	* 2" x 1 1/2" x 1/4" x 5" Long
7	R 3 1/2" x 3 1/2" x 1/2" (2 Total)





# CALCULATION SHEET

JOB NO. 9645

CALC. NO. Q1Z77, Q2Z77 REV. NO. A

PROJECT MISSISSIPPI POWER & LIGHT COMPANY

BY Vicent Kouykov DATE FEB 19, 82

SUBJECT GRAND GULF NUCLEAR STATION

CKD Robert M. White DATE 2/24/82

SOLENOID MOUNTING ID


SHEET NO. 24 OF 95

ACTUATOR Q1Z77f0033; FCN-M-1144

ASSUMPTIONS = (SEE MATH MODEL & DESIGN SKETCH FOR REF.)

- 1.) TREAT NODE 187 AS A FIXED JOINT
- 2.) ASSUME Q OF VERT. LEG ALONG THE MEMBER OF ITEM 3 INTERSECTS Q OF ITEM 2.
- 3.) USE BEAM OFFSET FOR MEMBER 20 TO CONNECT NODE 70 ON SOLENOID MOUNTING ID.
- 4.) TREAT ITEM 3 & ITEM 4 AS A UNIT MEMBER THROUGHOUT THE LENGTH OF CONNECTING WELD
- 5.) RELEASE M<sub>2</sub> @ NODE 192

NOTE, SEE DESIGN SKETCH & SECT. PROP FOR DIMENSIONS

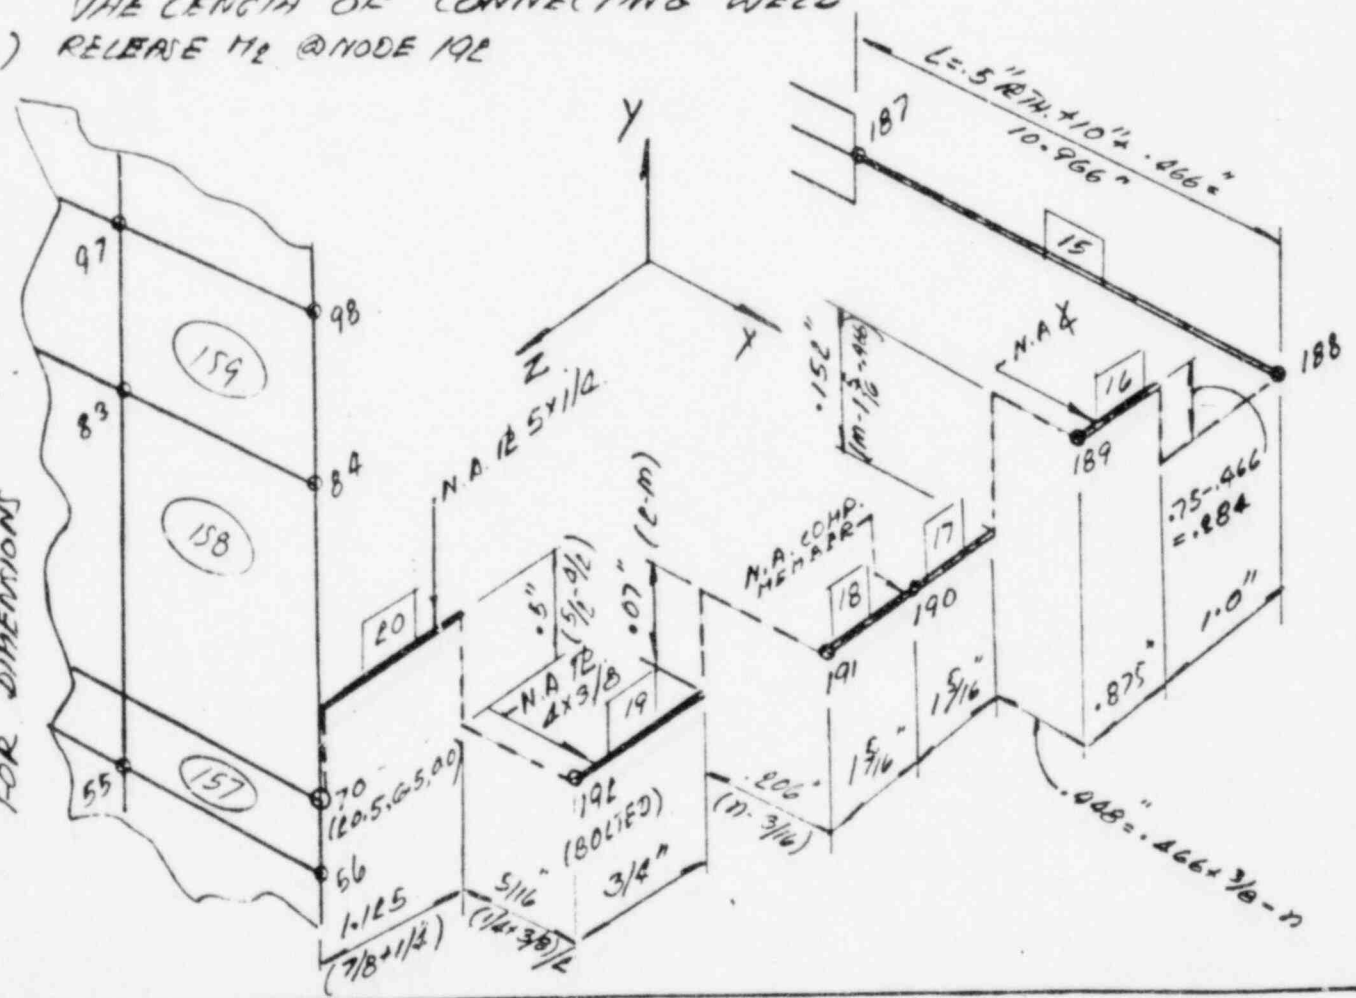



REF. DWG. OR SPEC. NO. 4645-0-601-024.13-5 REV. 5 TITLE Safety Related

REASON FOR CHANGE/EXISTING CONDITION Automatic Control Damper

Add support to slotted solenoid mounting plate on actuator Q12776002A.

CHANGE REQUEST/SKETCH (IF NECESSARY)

As-Built

See page 2

ATTACHMENT; 4, 1 OF 2

FOR INFORMATION ONLY Date: 3/10/82



WPAR / Q12776003-C

PFE APPROVED FOR - SUBMIT TO PROJECT ENGR.   
PFE APPROVED FOR - PROCEED WITH WORK   
PFE DISAPPROVED   
PFE: R. J. H. [Signature] DATE 2/9/82

PREPARED BY: [Signature] DATE 1/5/82  
ACTION BY ENGINEERING - DESCRIPTION OF CHANGE --

THIS IS: DCN # \_\_\_\_\_  
TO DWG # \_\_\_\_\_ REV. \_\_\_\_\_  
SCN # \_\_\_\_\_  
TO SPEC # \_\_\_\_\_ REV. \_\_\_\_\_  
DEVIATION # 0  
DATE \_\_\_\_\_  
PAGE \_\_\_\_\_ OF \_\_\_\_\_

REMARKS \_\_\_\_\_ RESP. ENGR: \_\_\_\_\_ DATE \_\_\_\_\_ CHKD: \_\_\_\_\_

GROUP SUPV. \_\_\_\_\_ DATE \_\_\_\_\_

CHIEF ENGINEER \_\_\_\_\_ DATE \_\_\_\_\_ PROJECT ENGR. APPROVAL YES  NO


BAR CHANGES YES  NO  COT - \_\_\_\_\_ DATE \_\_\_\_\_

TO: C. D. Wood ac: L. F. Dale; C. K. McCoy; T. E. Reeves File: 0080

SUPPLEMENTAL SHEET  
CHANGE REQUEST/NOTICE


FCM-  
GRAN NO. M-1146

PAGE 2 OF 2

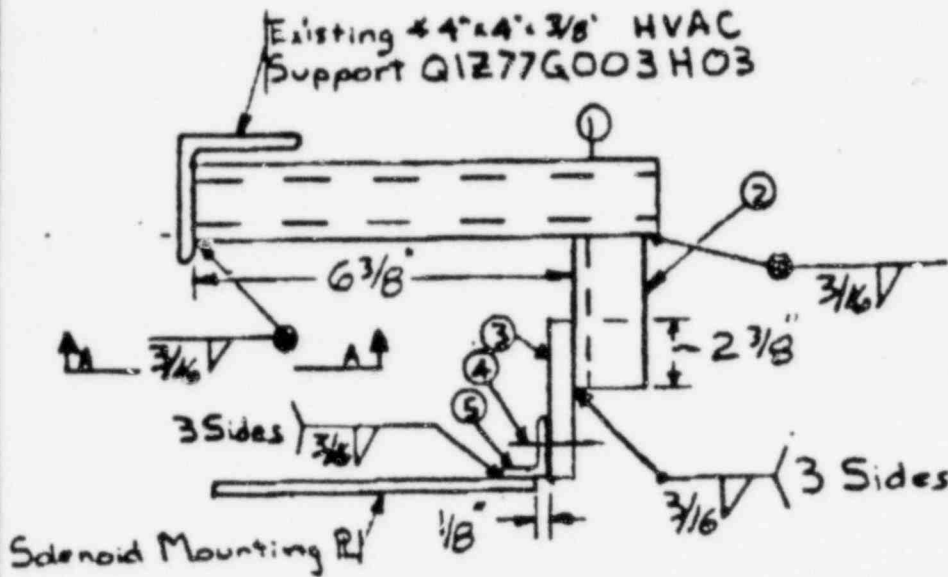

FOR INFORMATION  
ONLY Date: 3/10/82

ATTACHMENT; N, 2 OF 2

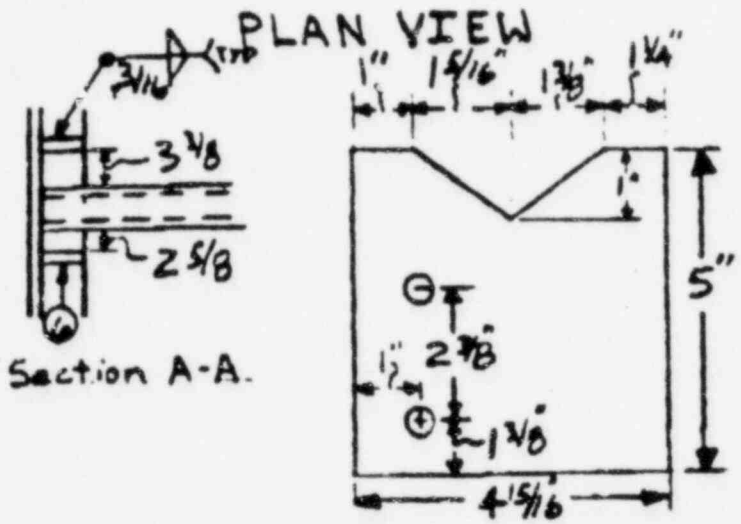

4 2" x 1/4" x 1/4" Bolted to back of plate as shown in Plan View w/ 2" long nutches to match plate. Bottom of R (item 3) & 2" x 1/4" x 1/4" (item 5) is 1/8" above bottom of Solenoid R.

BILL OF MATERIALS

ITEM#	DESCRIPTION
1	TS 3" x 3" x 1/4" x 9 7/8" Long
2	4 2" x 2" x 1/4" x 3 3/4" Long
3	R 4 5/16" x 5" x
4	2- 9/16" Ø holes for 2- 1/2" Ø A307 Bolts
5	4 2" x 1/4" x 1/4" x 5" Long
6	R 3 1/2" x 3 1/2" x 1/2" (2 total)





# CALCULATION SHEET

JOB NO. 9645

CALC. NO. Q1277, Q2277 REV. NO. A

PROJECT MISSISSIPPI POWER & LIGHT COMPANY

BY Oick. Raypp DATE FEB 22, 82


SUBJECT GRAND GULF NUCLEAR STATION

CKD Ray M. [Signature] DATE 2/24/82

SOLENOID MOUNTING RE

SHEET NO. 25 OF 95

ACTUATOR Q1277 G 002A, FCN-M-1146

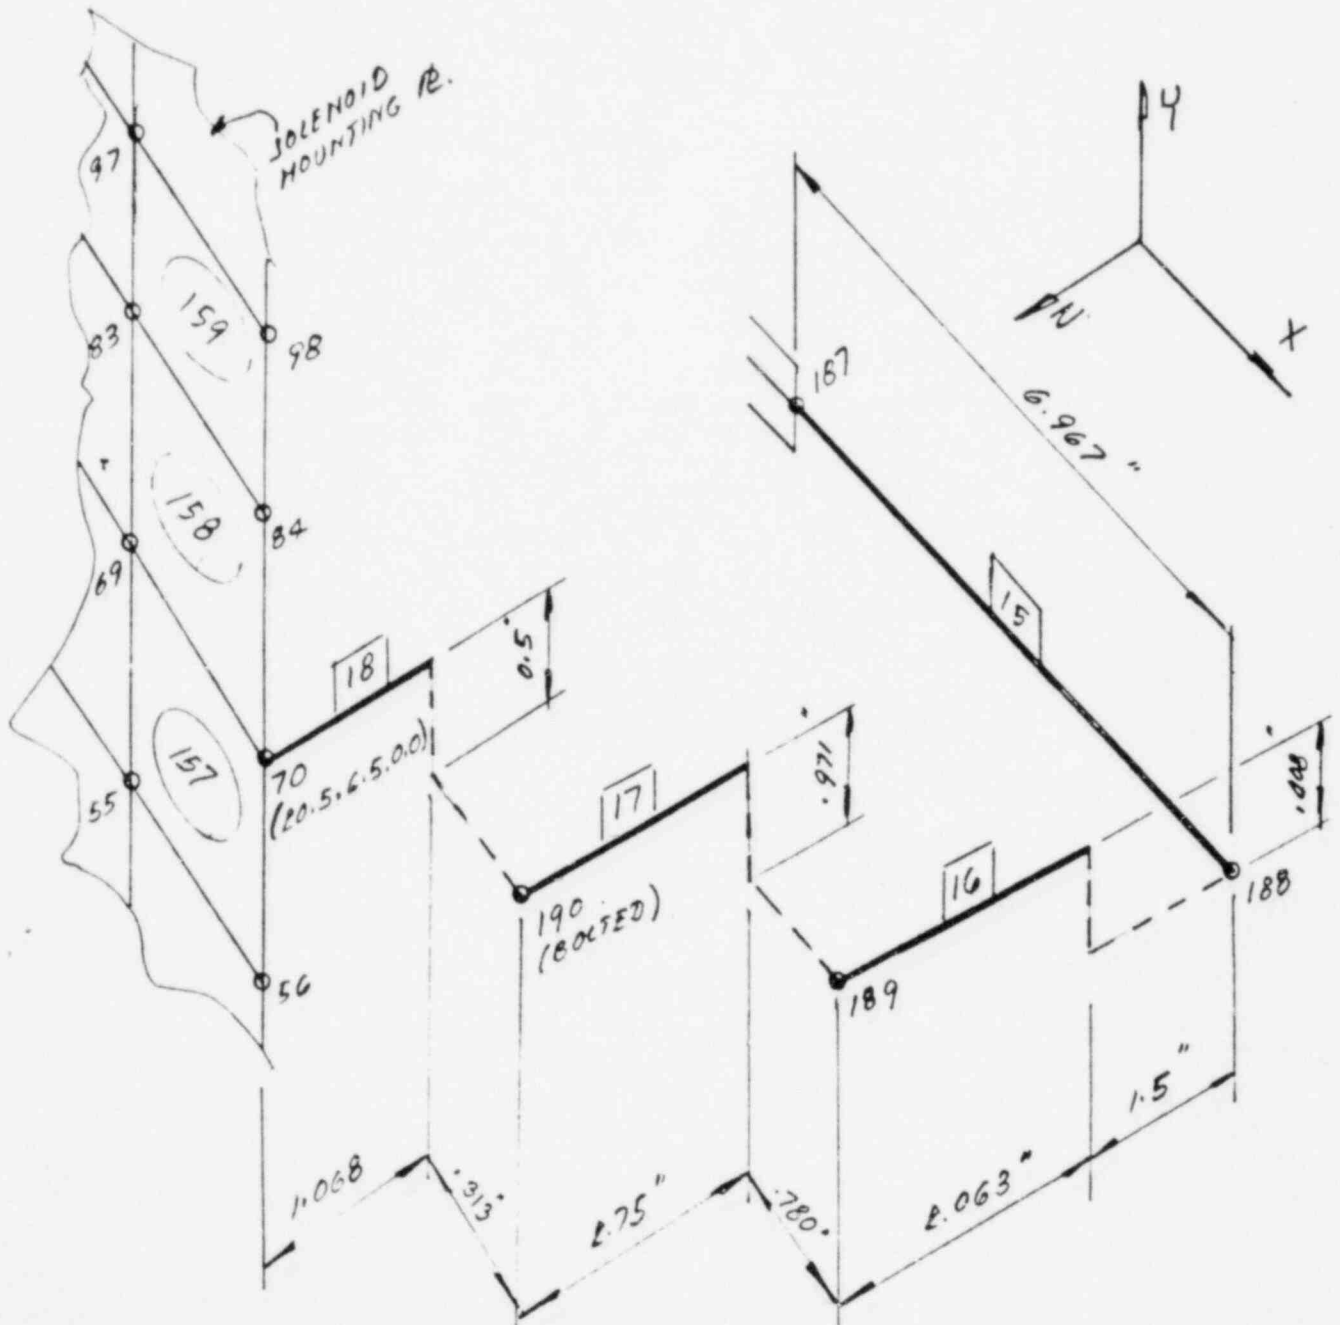

MATH - MODEL.





# CALCULATION SHEET

JOB NO. 9645

CALC. NO. Q1277, Q2277

REV. NO. A

PROJECT MISSISSIPPI POWER & LIGHT COMPANY

BY Vicki Roupay

DATE FEB 22, 82

SUBJECT GRAND GULF NUCLEAR STATION


CKD Gregg Mott

DATE 2/24/82

SOLENOID MOUNTING IR

SHEET NO. 26 OF 95

ASSUMPTIONS \* REFER TO DESIGN SHEET, MATH-MODEL & FIGURE BELOW.

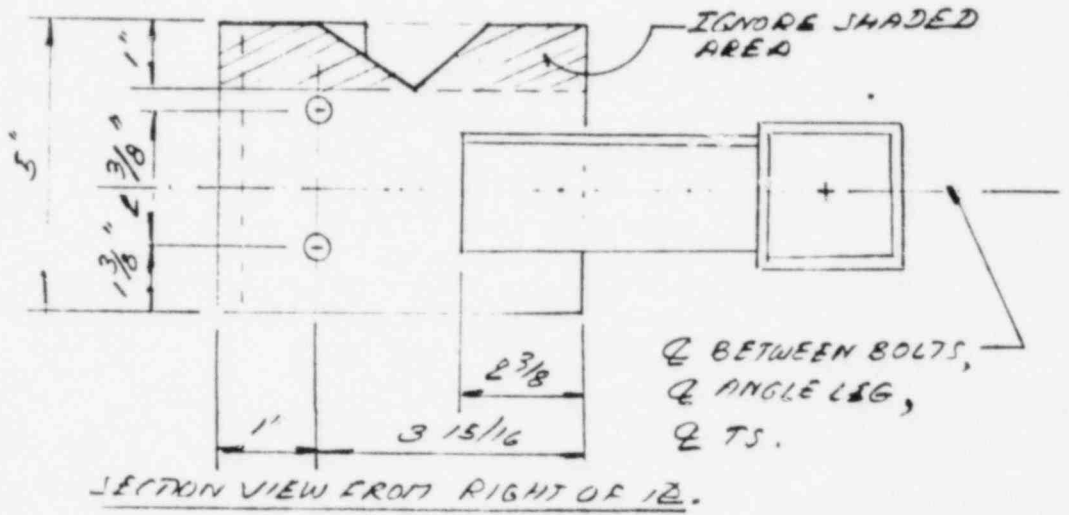

- 1.) ASSUMING THAT Q BETWEEN BOLTS, Q ANGLE LEG, & TS ARE AT THE SAME LEVEL
- 2.) IGNORE SHADED AREA OF THE IR.
- 3.) ANGLE IS CODED AS A BEAM. FROM EDGE OF TS. TO THE MID POINT OF OVERLAP OF ANGLE & THE IR.
- 4.) NODE 190 IN MATH-MODEL IS PIN CODED. IR, RELEASE M2.
- 5.) FIXED PT IS CODED @ NODE 187.
- 6.) ASSUME THE MID PT. OF THE ANGLE LENGTH (ITEM 5) LOADED @ NODE 70 OF SOLENOID MOUNTING IR.



MPL #

NIA

CHANGE REQUEST/NOTICE

Q 85  
NO

JOB NO. 9845

DRAWN FROM 1147

PAGE 1 OF 2

REF. DWG. OR SPEC. NO. 9845-671-02-11-65 REV. 5 TITLE Safety Related

REASON FOR CHANGE/EXISTING CONDITION Auto Control Damper

Add support to stiffen reload mounting plate on actuator Q1277602B.

(CHANGE REQUEST/SKETCH (IF NECESSARY))

As-Built

See page 2

ATTACHMENT; 0, 1 OF 2

FOR INFORMATION ONLY Date: 3/10/82



WPLM: Q1277602-C

PREPARED BY: *Lead 2/4/82* *Dennis Maloney* DATE 2/15/82PFE APPROVED FOR - SUBMIT TO PROJECT ENGR. PFE APPROVED FOR - PROCEED WITH WORK PFE DISAPPROVED PFE: *[Signature]* DATE 2/19/82

ACTION BY ENGINEERING - DESCRIPTION OF CHANGE..

THIS IS: DCN # \_\_\_\_\_

TO DWG # \_\_\_\_\_ REV. \_\_\_\_\_

SCH # \_\_\_\_\_

TO SPEC # \_\_\_\_\_ REV. \_\_\_\_\_

DEVIATION # D \_\_\_\_\_

DATE \_\_\_\_\_

PAGE \_\_\_\_\_ OF \_\_\_\_\_


REMARKS \_\_\_\_\_ RESP. ENGR: \_\_\_\_\_ DATE \_\_\_\_\_ CHKD: \_\_\_\_\_

GROUP SUPV. \_\_\_\_\_ DATE \_\_\_\_\_


CHIEF ENGINEER \_\_\_\_\_ DATE \_\_\_\_\_ PROJECT ENGR. APPROVAL YES  NO BAR CHANGES YES  NO  CDT - \_\_\_\_\_ DATE \_\_\_\_\_

TD: C. D. Wood as: L. F. Dak; C. K. McCoy; T. E. Reeves File: 0080/

SUPPLEMENTAL SHEET  
 CHANGE REQUEST/NOTICE  
 Existing 4'3" x 3' x 3/8" HVAC Support Q12776004H10

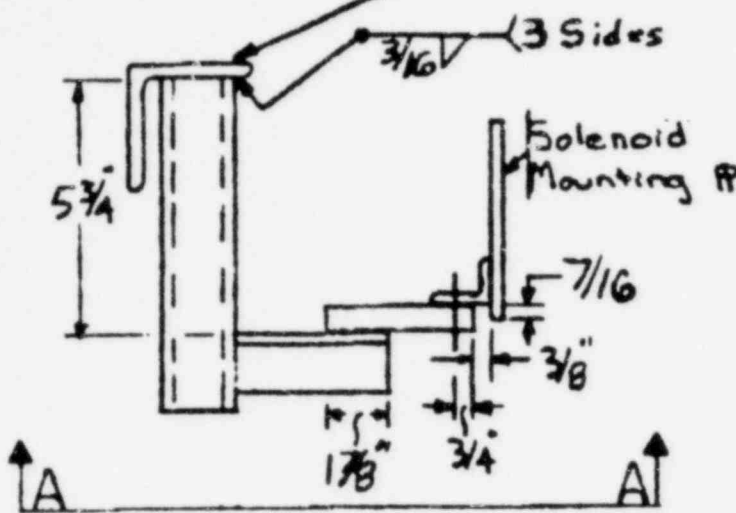

PLAN VIEW

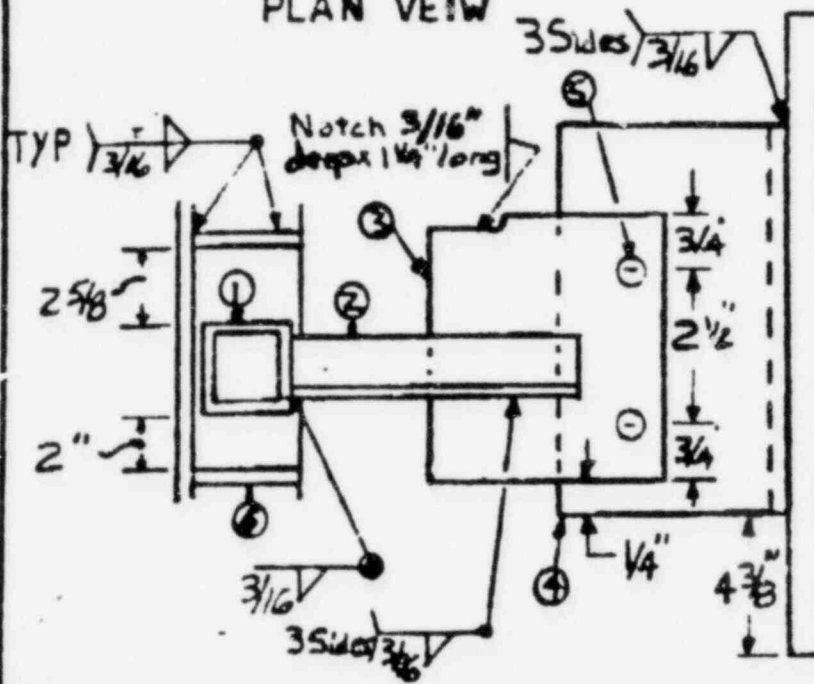

Section A-A

Bill of Materials  
 Item Description

- 1 TS 2" x 2" x 1/4" x 7 3/4"
- 2 x 1 1/2" x 1 1/2" x 5/8" x 1/2"
- 3 R 4" x 3" x 3/8"
- 4 x 2" x 1 1/2" x 1/4" x 5/8"
- 5 2 - 7/16" Ø  
 holes for 2 -  
 1/2" Ø A307  
 Bolts w/  
 NUTS
- 6 R 2 1/2" x 2 1/2" x 3/8"  
 (2 total)

FOR INFORMATION  
 ONLY Date: 3/10/82

ATTACHMENT; 0, 2 OF 2







# CALCULATION SHEET

JOB NO. 9625CALC. NO. Q1277, Q2277 REV. NO. APROJECT MISSISSIPPI POWER & LIGHT COMPANYBY Vicki Knapov DATE FEB 20, 82SUBJECT GRAND GULF NUCLEAR STATIONCKD J. J. Mott DATE 3/1/82SOLENOID MOUNTING RSHEET NO. 28 OF 95

ASSUMPTIONS: REFER TO DESIGN SKETCH & MATH MODEL.

- 1.) ON SECT A-A OF DESIGN SKETCH, ASSUMING THAT  $Q$  OF ITEM 1,  $Q$  OF VERT. LEG OF ITEM 2, &  $Q$  OF ITEM 3 ARE AT THE SAME ELEVATION
- 2.) IGNORE THE NOTCH OF ITEM 3
- 3.) ITEM 2 IS CODED AS A BEAM (#16) W/  $1\frac{1}{2}'' \times 1\frac{1}{2}'' \times \frac{1}{2}''$  SECTION. FROM EDGE OF ITEM 1 TO THE MID POINT OF OVERLAP OF ITEM 2 & ITEM 3 ( $1\frac{7}{8}''$ )
- 4.) NODE 190 ON MATH-MODEL IS PIN CODED IN; RELEASE 1/2.
- 5.) FIXED PT. IS CODED @ NODE 187



MPL #

N/A

CHANGE REQUEST/NOTICE

Q   
NO 

JOB NO. 9645

CR. NO. ECN-19-1/98PAGE 1 OF 2REF. DWG. OR SPEC. NO. 9645-M-612.5-21-61-6-5 REV. 5TITLE Safety Related

REASON FOR CHANGE/EXISTING CONDITION

Auto Control AmpersAdd support to stiffen elevator mounting platform  
actuator Q227750020.

CHANGE REQUEST/SKETCH (IF NECESSARY)

As-Built

See page 2

ATTACHMENT; P, 1 OF 2FOR INFORMATION  
ONLY Date: 3/10/82WPAR # Q22775004-CPFE APPROVED FOR - SUBMIT TO PROJECT ENG. PFE APPROVED FOR - PROCEED WITH WORK PFE DISAPPROVED PFE: Ry Alexander DATE 2/10/82PREPARED BY: James Melton DATE 1/15/82

ACTION BY ENGINEERING - DESCRIPTION OF CHANGE --

THIS IS: DCN # \_\_\_\_\_

TO DWG # \_\_\_\_\_ REV. \_\_\_\_\_

SCN # \_\_\_\_\_

TO SPEC # \_\_\_\_\_ REV. \_\_\_\_\_

DEVIATION # D \_\_\_\_\_

DATE \_\_\_\_\_

PAGE \_\_\_\_\_ OF \_\_\_\_\_

REMARKS \_\_\_\_\_ RESP. ENGR: \_\_\_\_\_ DATE \_\_\_\_\_ CHKD: \_\_\_\_\_

GROUP SUPV. \_\_\_\_\_ DATE \_\_\_\_\_



CHIEF ENGINEER \_\_\_\_\_ DATE \_\_\_\_\_ PROJECT ENGR. APPROVAL YES  NO SAR CHANGES YES  NO  CDT - \_\_\_\_\_ DATE \_\_\_\_\_

TO: C. D. Wood cc: L. F. Dale; G. K. McCoy; T. E. Rasmus File: 00801

SUPPLEMENTAL SHEET  
CHANGE REQUEST/NOTICE

ECN-  
Draw No. M-1148

PAGE 2 OF 2

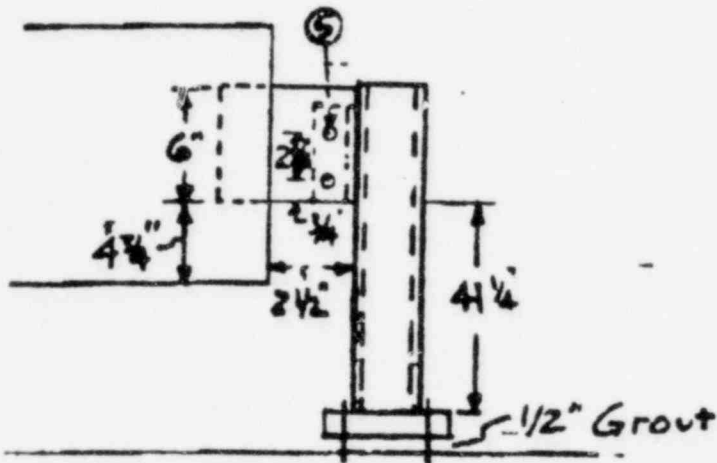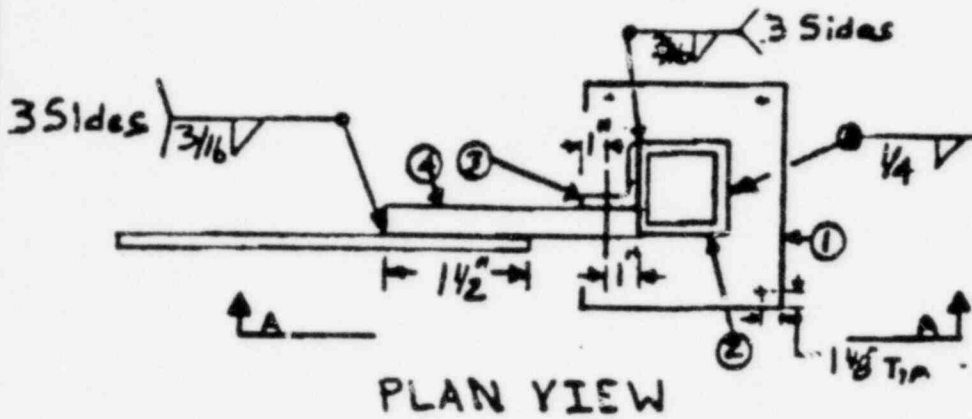

Section A-A

FOR INFORMATION  
ONLY Date: 3/10/82

ATTACHMENT; P, 2 OF 2

BILL OF MATERIALS

ITEM#	DESCRIPTION
1	R 8" x 8" x 1/2" W / 4 - 1/2" $\emptyset$ hilti bolts 5 1/2" Long
2	TS 3" x 3" x 1/4" = 4 1/2" Long
3	4 2" x 2" x 1/4" x 4" ang
4	R 4" x 6" x 3/8"
5	2 - 9/16" $\emptyset$ holes for 2 - 1/2" $\emptyset$ A307 Bolts







# CALCULATION SHEET

JOB. NO. 9685

CALC. NO. Q1277, Q2277 REV. NO. A

PROJECT MISSISSIPPI POWER & LIGHT COMPANY

BY Dick Rapp DATE FEB 19, 82


SUBJECT GRAND GULF NUCLEAR STATION

CKD Stephen A. Descoteaux DATE 2/19/82

SOLENOID MOUNTING PLATE

SHEET NO. 30 OF 95

## ASSUMPTIONS

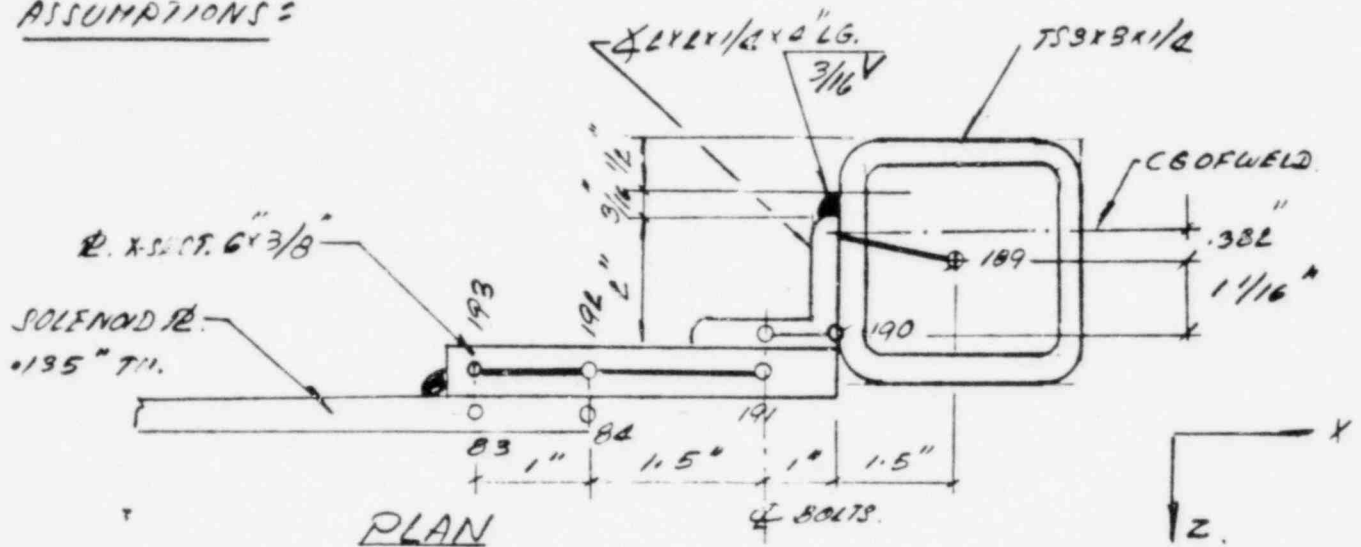

REFER TO MATH-MODEL & DIAN VIEW ON THIS PAGE.

- 1.) TREAT MEH'S 19, 20 AS BEAM W/ X-SEC. OF 6X3/8
- 2.) TREAT MEH 18 AS BEAM W/ X-SEC. OF 4X1/2
- 3.) DISTRIBUTE FORCES FROM SOLENOID MOUNTING PLATE TO THE ATTACHED PLATE 6X3/8 BY MEH'S 22-28 (USING 759X8X1/2)
- 4.) TREAT MEH 17 AS BEAM W/ X-SEC. OF 759X8X1/2
- 5.) RELEASE MOMENT @ WEAK AXIS OF MEH 19 @ NODE 191



# CALCULATION SHEET

JOB NO. 9645

CALC. NO. Q1Z77, Q2Z77 REV. NO. A

PROJECT MISSISSIPPI POWER & LIGHT COMPANY

BY Crd. Wray DATE MAR 3, 82

SUBJECT GRAND GULF NUCLEAR STATION

CKD Stephen A. Descoteaux DATE 5/4/82

SOLENOID MOUNTING PL.

SHEET NO. 31 OF 95



WELD.  $\frac{1}{8}$  EXX1/8 TO TS 3X3X1/2

ASSUME THAT WELD CAN NOT  
BE DONE AT CORNER OF TS.

i.e. L OF WELD =  $3 - .5 - 3/16 - .5 = 1 \frac{13}{16}$  "


CG. OF WELD;  $n$

$$n = \frac{2 \left(1 \frac{13}{16}\right)^2 \times \frac{1}{2}}{2 \left(1 \frac{13}{16}\right) + 4} = .431 \text{ IN}$$

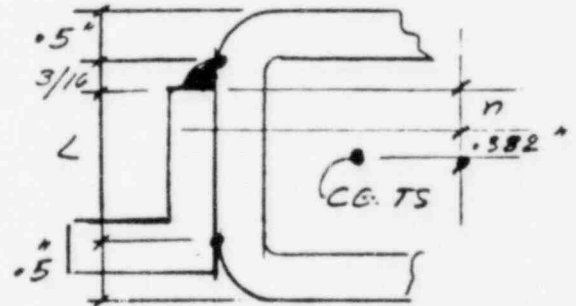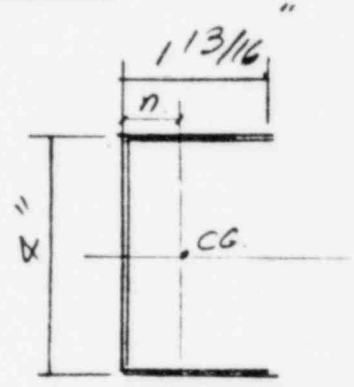



# CALCULATION SHEET

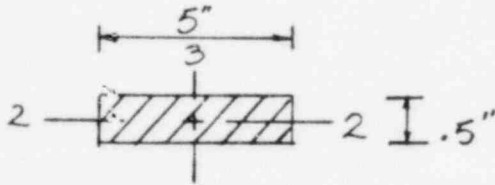JOB NO. 9645CALC. NO. Q1277 & Q2277REV. NO. APROJECT MISSISSIPPI POWER & LIGHT COMPANYBY Stephen A. DescoteauxDATE 1/29/82SUBJECT GRAND GULF NUCLEAR STATIONCKD [Signature]DATE 2/16/82SOLENOID MOUNTING PLATESHEET NO. 32 OF 95R 1/2" x 5"1

$$A = 5(.5) = 2.5 \text{ IN}^2$$

$$J = R = \beta b d^3 = .313(5)(.5)^3 = .196 \text{ IN}^4$$

$$I_{2-2} = \frac{5(.5)^3}{12} = .052 \text{ IN}^4$$

$$I_{3-3} = \frac{.5(5)^3}{12} = 5.208 \text{ IN}^4$$

$$SF2 = SF3 = 0.85$$

$$H2 = 5.0 \text{ IN}$$

$$H3 = .5 \text{ IN}$$

$$CT = 0.5 \text{ IN}$$

$$SSF2 = SSF3 = 1.5$$



# CALCULATION SHEET

JOB NO. 9645CALC. NO. Q1277, Q2277REV. NO. APROJECT MISSISSIPPI POWER & LIGHT COMPANYBY Stephen A. DesrosiersDATE 2/1/82SUBJECT GRAND GULF NUCLEAR STATIONCKD [Signature]DATE 2/16/82SOLENOID MOUNTING PLATESHEET NO. 33 OF 95TS 4x4x 1/42

$$A = 3.54 \text{ IN}^2$$


$$J = \frac{2(.25)(3.75)^2(3.75)^2}{3.75 + 3.75} = 13.184 \text{ IN}^4$$

$$I_2 = I_3 = 8.00 \text{ IN}^2$$

$$SF_2 = SF_3 = \frac{2(4.0 - .25) \cdot .25}{3.54} = 0.53$$

$$H_2 = H_3 = 4.0 \text{ IN}$$

$$C_T = \frac{3.75(3.75)}{3.75 + 3.75} = 1.875 \text{ IN.}$$

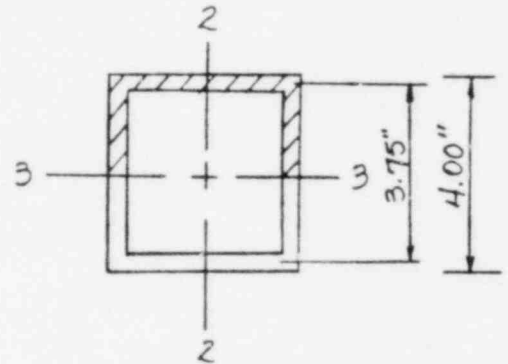

$Q_2 = Q_3 =$  STATICAL MOMENT OF CROSS-HATCHED AREA ABOUT NEUTRAL AXIS

$$Q_2 = Q_3 = 4.0(.25)(1.875) + \frac{2(1.75)^2(.25)}{2} = 2.641 \text{ IN}^3$$

$$SSF_2 = SSF_3 = \frac{QA}{I_t} = \frac{2.641(3.54)}{8.00(2 \times .25)} = 2.337$$



# CALCULATION SHEET

JOB NO. 9645CALC. NO. Q1277, Q2277 REV. NO. APROJECT MISSISSIPPI POWER & LIGHT COMPANYBY Stephen A. Descoteaux DATE 2/5/82SUBJECT GRAND GULF NUCLEAR STATIONCKD [Signature] DATE 2/16/82SOLENOID MOUNTING PLATESHEET NO. 34 of 95L 2 x 2 x 1/4**3**

$$A = .938 \text{ IN}^2$$

$$b/d = \frac{2}{.25} = 8.0, \therefore \beta = .307$$

$$R = 2 \beta b d^3 = 2(.307)(2.0)(.25)^3 = .019 \text{ IN}^4$$

$$I_{2-2} = I_{3-3} = .348 \text{ IN}^4$$

$$SF_2 = SF_3 = \frac{2(.25)}{.938} = .533$$


$$H_2 = 2.816 \text{ IN.}$$

$$H_3 = 2.816 \text{ IN.}$$

$$C_T = 0.25 \text{ IN.}$$


$$Q_2 = Q_3 = \frac{.25(1.408)^2}{2} = .2478 \text{ IN}^3$$

$$SSF_2 = SSF_3 = \frac{QA}{I \pm} = \frac{.2478(.938)}{.348(.25)} = 2.672$$

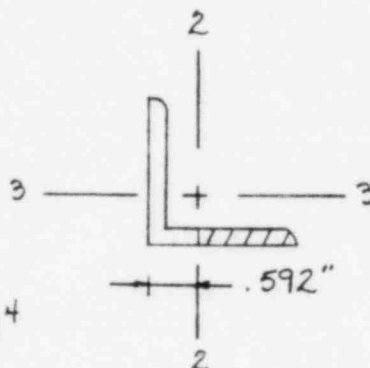



# CALCULATION SHEET

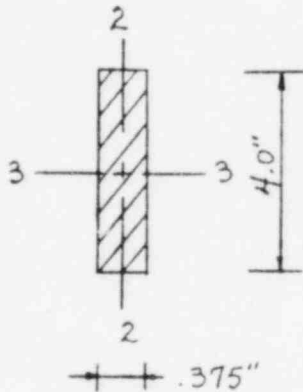JOB NO. 9645CALC. NO. Q1277, Q2277REV. NO. APROJECT MISSISSIPPI POWER & LIGHT COMPANYBY Stephen A. DescoteauxDATE 2/5/82SUBJECT GRAND GULF NUCLEAR STATIONGRD [Signature]DATE 2/16/82SOLENOID MOUNTING PLATESHEET NO. 35 OF 95ϕ 3/8" x 4"4

$$A = 4.0 (.375) = 1.5 \text{ IN}^2$$

$$J = R = \beta b d^3 = .314 (4.0) (.375)^3 = .066 \text{ IN}^4$$

$$I_{2-2} = \frac{4.0 (.375)^3}{12} = .018 \text{ IN}^4$$

$$I_{3-3} = \frac{.375 (4.0)^3}{12} = 2.0 \text{ IN}^4$$

$$SF2 = SF3 = 0.85$$

$$H_2 = 4.0 \text{ IN.}$$

$$H_3 = 0.375 \text{ IN.}$$

$$C_T = 0.375 \text{ IN.}$$

$$SSF2 = SSF3 = 1.5$$




# CALCULATION SHEET

JOB NO. 9645CALC. NO. Q1277, Q2277 REV. NO. APROJECT MISSISSIPPI POWER & LIGHT COMPANYBY [Signature] DATE 2-8-82SUBJECT GRAND GULF NUCLEAR STATIONCKD Vict. Waypol DATE 2.16.82SOLENOID MOUNTING PLATESHEET NO. 36 OF 95

5

## SECTION PROPERTIES

TS 2" x 2" x 1/4"

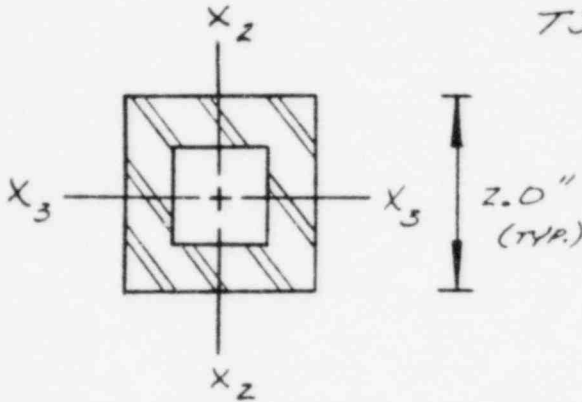

$$A = 1.59 \text{ IN}^2$$

$$I_2 = I_3 = 0.766 \text{ IN}^4$$

$$J = \frac{2(0.25)(1.75)^2(1.75)^2}{1.75 + 1.75}$$

$$J = 1.3398 \text{ IN}^4$$

$$SF_2 = SF_3 = \frac{2(b-t)(t)}{A} = \frac{2(2.0-0.25)(0.25)}{2.59}$$

$$SF_2 = SF_3 = 0.5503$$

$$CT = \frac{[A]}{b+d} = \frac{(1.75)^2}{1.75 + 1.75} = 0.875$$

$$Q_2 = Q_3 = [0.875(0.25)(2.0) + 2(0.25)(1.75)(0.375)]$$

$$Q_2 = Q_3 = 0.5781 \text{ IN}^3$$

$$SSF_2 = SSF_3 = \frac{0.5781 \text{ IN}^3 (1.59)}{0.766 (2)(0.25)} = 2.40$$

$$H_2 = H_3 = 2.0 \text{ IN}$$




# CALCULATION SHEET

JOB NO. 9645CALC. NO. Q1277, Q2277REV. NO. APROJECT MISSISSIPPI POWER & LIGHT COMPANYBY [Signature]DATE 2-8-82SUBJECT GRAND GULF NUCLEAR STATIONCKD Wid. Nayroy.DATE 4/16/88SOLENOID MOUNTING PLATESHEET NO. 37 OF 95

## SECTION PROPERTIES

6

75 3"x3"x 1/4"

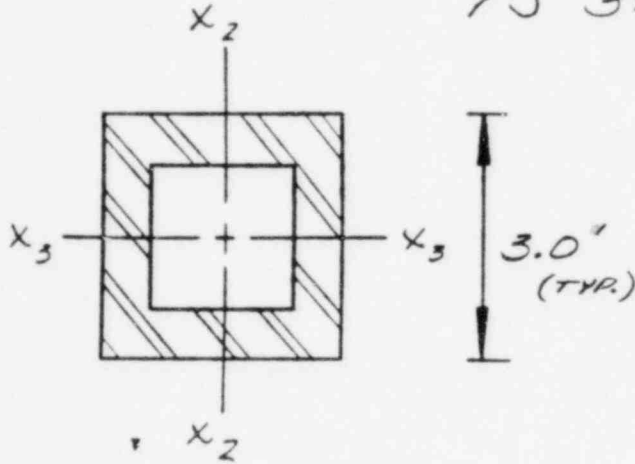

$$A = 2.59 \text{ in}^2$$

$$I_2 = I_3 = 3.16 \text{ in}^4$$

$$J = \frac{2(0.25)(2.75)^2(2.75)^2}{2.75 + 2.75}$$

$$J = 5.199 \text{ in}^4$$

$$SF_2 = SF_3 = \frac{2(b-t)t}{A} = \frac{2(3.0 - 0.25)(0.25)}{2.59} = 0.531$$

$$C_T = \frac{[A]}{b+d} = \frac{2.75(2.75)}{2.75 + 2.75} = 1.375$$

$$Q_2 = Q_3 = [1.375(0.25)(3.0) + 2(0.25)(1.25)(0.625)]$$

$$Q_2 = Q_3 = 1.422$$

$$SSF_2 = SSF_3 = \frac{1.422(2.59)}{3.16(2)(0.25)} = 2.331$$

$$H_2 = H_3 = 3.0 \text{ in}$$





# CALCULATION SHEET


JOB NO. 9645CALC. NO. Q1217, Q2277REV. NO. APROJECT MISSISSIPPI POWER & LIGHT COMPANYBY [Signature]DATE 2-10-82SUBJECT GRAND GULF NUCLEAR STATIONCKD Dial. DraytonDATE 2.16.82

Solenoid Mounting Plate SHEET NO.

38 OF 95

7

## SECTION PROPERTIES

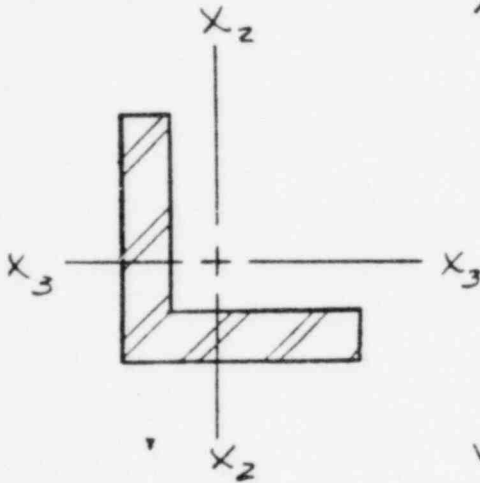L 1 1/2" x 1 1/2" x 1/4"

$$A = 0.688 \text{ in}^2$$

$$b/d = 1.50 / 0.25 = 6.0$$

$$B = 0.299$$

$$J = R = Bbd^3 = 2(0.299)(1.5)(0.25)^3$$

$$J = 0.014 \text{ in}^4$$

$$I_2 = I_3 = 0.139 \text{ in}^4$$

$$SF_2 = SF_3 = \frac{1.5(0.25)}{0.688} = 0.545$$

$$H_2 = H_3 = 2.068 \text{ in}$$

$$C_T = 0.25$$

$$Q_2 = Q_3 = \frac{0.25(1.034)^2}{2} = 0.1336 \text{ in}^3$$

$$SSF_2 = SSF_3 = \frac{QA}{It} = \frac{0.1336(0.688)}{0.139(0.25)} = 2.645$$



# CALCULATION SHEET

JOB NO. 9645CALC NO. Q1277, Q2277 REV. NO. APROJECT MISSISSIPPI POWER & LIGHT COMPANYBY Uncl. Group DATE FEB. 11. 82SUBJECT GRAND GULF NUCLEAR STATIONCKD [Signature] DATE 2-16-82SOLENOID HOUSING PLATESHEET NO. 39 OF 95

8

ANGLE 2" x 1 1/2" x 1/4"

$$A = .813 \text{ in}^2$$

$$I_2 = .151 \text{ in}^4$$

$$I_3 = .316 \text{ in}^4$$

$$J = \sum \beta d^3$$

$$= .307(2)(.25)^3 + .290(1.25)(.25)^3$$

$$= .01526 \text{ in}^4$$

$$C_{TOP} = .25 \text{ in}$$

$$H_2 = 2.670 \text{ in}$$

$$H_3 = 2.174 \text{ in}$$

$$SF_3 = \frac{2 \times .25}{.813} = .61501$$


$$SF_2 = \frac{1.5 \times .25}{.813} = .46185$$

$$Q_2 = \frac{(1.25 \times 1.087)(1.087)}{2} = .14770 \text{ in}^3$$

$$Q_3 = \frac{(1.25 \times 1.337)(1.337)}{2} = .22305 \text{ in}^3$$

$$SSF_2 = \frac{.14770 \times .813}{.151 \times .25} = 3.18099$$

$$SSF_3 = \frac{.22305 \times .813}{.316 \times .25} = 2.29956$$

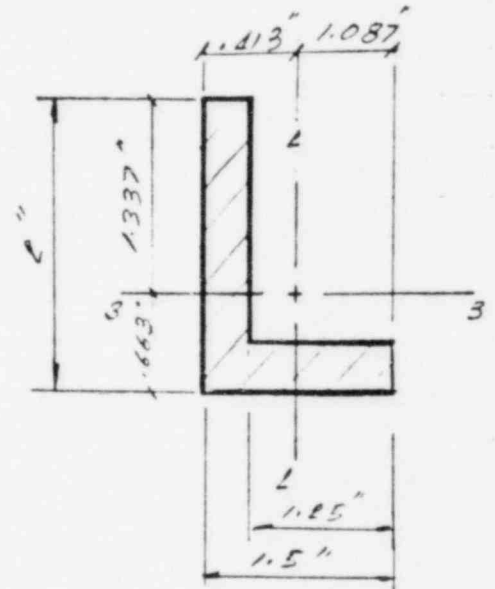



# CALCULATION SHEET

JOB NO. 9625CALC. NO. Q1277, Q2277REV. NO. APROJECT MISSISSIPPI POWER & IGH COMPANYBY Vic. Gray Jr.DATE FEB. 11. 82SUBJECT GRAND GULF NUCLEAR STATIONCKD Greg WittkeDATE 2/16/82SOLENOID MOUNTING PLATESHEET NO. 40 OF 95

9

PLATE 3 1/2" x 1/2"

$$A = 3.5 \times 0.5 = 1.75 \text{ IN}^2$$

$$I_2 = \frac{1}{12} \times 3.5 \times (0.5)^3 = .03646 \text{ IN}^4$$

$$I_3 = \frac{1}{12} \times 0.5 \times (3.5)^3 = 1.78646 \text{ IN}^4$$

$$J = \frac{1}{3} b d^3 \quad (\text{BUDGETT P. 2.10-2})$$
$$= \frac{1}{3} \times 0.5 \times (3.5)^3$$
$$= .13856 \text{ IN}^4$$


$$SF_2 = SF_3 = 0.85$$

$$H_2 = 3.5 \text{ IN}$$

$$H_3 = 0.5 \text{ IN}$$

$$SSF_2 = SSF_3 = 1.5$$

$$C_T = 0.5 \text{ IN}$$

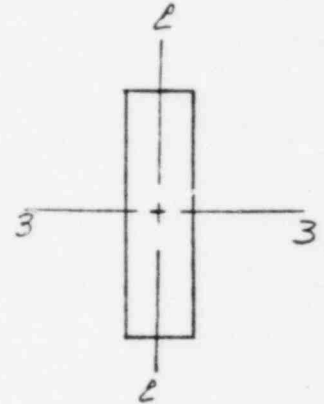



# CALCULATION SHEET

JOB NO. 9645CALC. NO. Q1277, Q2277 REV. NO. APROJECT MISSISSIPPI POWER & LIGHT COMPANYBY Vic/Grampol DATE FEB. 12. 82SUBJECT GRAND GULF NUCLEAR STATIONCKD Roger M. ... DATE 2/16/82SOLENOID MOUNTING PLATESHEET NO. 41 OF 95

10

PLATE 4 1/2 X 3/8

$$A = 4.5 \times .375 = 1.6875 \text{ in}^2$$

$$I_x = \frac{1}{12} (4.5) (.375)^3 = .01978 \text{ in}^4$$

$$I_y = \frac{1}{12} (.375) (4.5)^3 = 2.80766 \text{ in}^4$$

$$J = .333 (4.5) (.375)^3 = .07902 \text{ in}^4$$


$$C_{TOR} = .375 \text{ in}$$

$$H_x = 4.5 \text{ in}$$

$$H_y = .375 \text{ in}$$

$$SF_x = SF_y = 0.85$$

$$SSF_x = SSF_y = 1.50$$

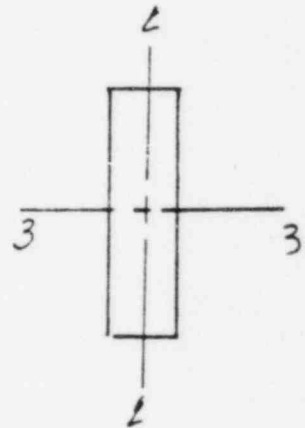



# CALCULATION SHEET

JOB NO. 9645CALC. NO. Q1277, Q2277REV. NO. APROJECT MISSISSIPPI POWER & LIGHT COMPANYBY Vic J. KrappDATE FEB. 12. 82SUBJECT GRAND GULF NUCLEAR STATIONCKD Roger MitchellDATE 2-16-82SOLENOID MOUNTING PLATESHEET NO. 42 OF 95

11


## ANGLE 3 X 1 1/2 X 1/2

$$A = (3 \times 1.5) - (2.75 \times 1.25) = 1.0625 \text{ IN}^2$$

NEUTRAL AXES (m, n)

$$m = \frac{(3 \times 1.5) \cdot 1.5 - (2.75 \times 1.25) \times 2.75}{1.0625} = 1.904 \text{ IN.}$$

$$n = \frac{(3 \times 1.5) \cdot \frac{1.5}{2} - (2.75 \times 1.25) \times \frac{1.25}{2}}{1.0625} = 1.154 \text{ IN.}$$

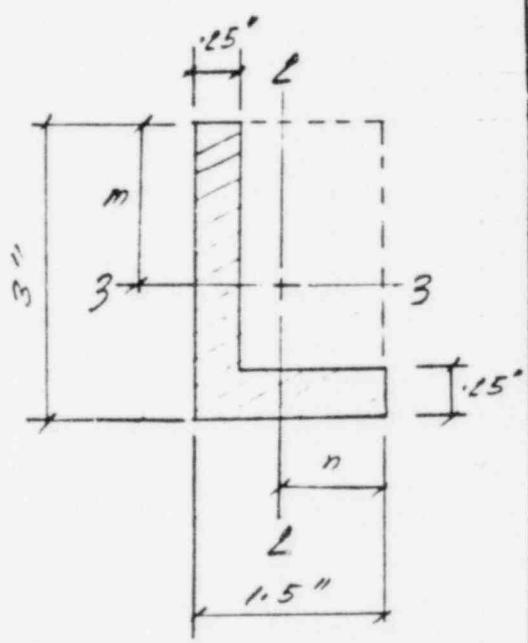

$$I_3 = \left[ \left( \frac{1}{12} \times 1.5 \times 3^3 \right) + (3 \times 1.5) \left( 1.904 - \frac{3}{2} \right)^2 \right] - \left[ \left( \frac{1}{12} \times 1.25 \times 2.75^3 \right) + (1.25 \times 2.75) \left( 1.904 - \frac{2.75}{2} \right)^2 \right]$$

$$= 0.98118 \text{ IN}^4$$

$$I_2 = \left[ \left( \frac{1}{12} \times 3 \times 1.5^3 \right) + (3 \times 1.5) \left( 1.154 - \frac{1.5}{2} \right)^2 \right] - \left[ \left( \frac{1}{12} \times 2.75 \times 1.25^3 \right) + (2.75 \times 1.25) \left( 1.154 - \frac{1.25}{2} \right)^2 \right]$$

$$= 0.16868 \text{ IN}^4$$

$$J = \sum \beta b d^3 = 0.313 (2.75) (0.25)^3 + 0.299 (1.5) (0.25)^3 = 0.02046 \text{ IN}^4$$

$$C_{10R} = 0.25 \text{ IN}$$

$$H_2 = 3.808 \text{ IN}$$

$$H_3 = 2.308 \text{ IN}$$

$$SF_3 = \frac{3 \times 0.25}{1.0625} = 0.70588$$

$$SF_2 = \frac{1.5 \times 0.25}{1.0625} = 0.35294$$

$$SSF_2 = \frac{Q_2 A}{I_2 t} = \frac{(1.154 \times 0.25) \cdot \frac{1.154}{2} \times 1.0625}{0.16868 \times 0.25} = 2.1902$$

$$SSF_3 = \frac{Q_3 A}{I_3 t} = \frac{(1.904 \times 0.25) \cdot \frac{1.904}{2} \times 1.0625}{0.98118 \times 0.25} = 1.9629$$



# CALCULATION SHEET

JOB NO. 9645CALC. NO. Q1277, Q2277 REV. NO. APROJECT MISSISSIPPI POWER & LIGHT COMPANYBY Virgil Saup. DATE FEB. 12. 82SUBJECT GRAND GULF NUCLEAR STATIONCKD Roger Matthe DATE 2/16/82SOLENOID MOUNTING PLATESHEET NO. 43 OF 95

12

## PLATE 4 1/8 x 3/8

$$A = 4.125 \times .375 = 1.5469 \text{ in}^2$$

$$I_2 = \frac{1}{12} (4.125)(.375)^3 = .01813 \text{ in}^4$$

$$I_3 = \frac{1}{12} (.375)(4.125)^3 = 2.19301 \text{ in}^4$$

$$J = \beta b d^3$$

$$= .313 (4.125)(.375)^3 = .06809 \text{ in}^4$$


$$C_{TOR} = .375 \text{ in}$$

$$H_2 = 4.125 \text{ in}$$

$$H_3 = .375 \text{ in}$$

$$SF_2 = SF_3 = .85$$

$$SSF_2 = SSF_3 = 1.50$$

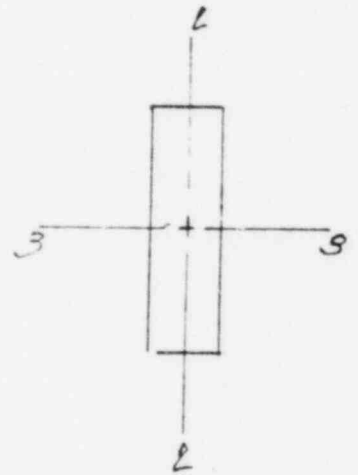




# CALCULATION SHEET

JOB NO. 9645CALC. NO. Q1277, Q2277 REV. NO. APROJECT MISSISSIPPI POWER & LIGHT COMPANYBY [Signature] DATE 2-12-82SUBJECT GRAND GULF NUCLEAR STATIONCKD Vic. Grayson DATE 2.16.82SOLENOID MOUNTING PLATESHEET NO. 44 OF 95

13

## SECTION PROPERTIES

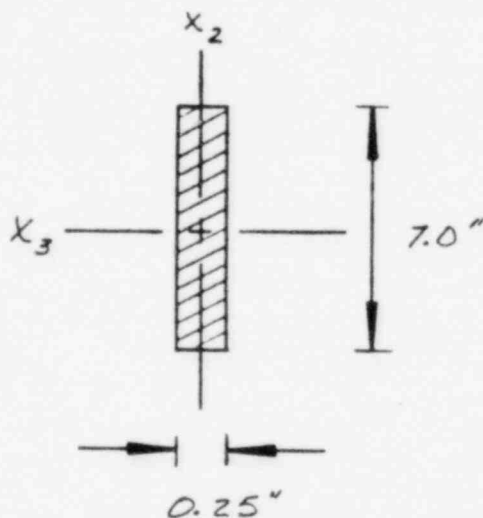PLATE 7" x 1/4"

$$A = 7.0 (0.25) = 1.75 \text{ IN}^2$$

$$J = R = \frac{3bd^3}{12} \approx 0.327 (7.0)(0.25)^3 = 0.036 \text{ IN}^4$$

$$I_{2-2} = \frac{7.0 (0.25)^3}{12} = 0.0091 \text{ IN}^4$$

$$I_{3-3} = \frac{0.25 (7.0)^3}{12} = 7.146 \text{ IN}^4$$

$$SF_2 = SF_3 = 0.85$$

$$H_2 = 7.0 \text{ IN} \quad H_3 = 0.25 \text{ IN}$$

$$C_T = 0.25$$

$$SSF_2 = SSF_3 = 1.50 \text{ IN}$$



# CALCULATION SHEET

JOB NO. 9645CALC NO. Q1277, Q2277 REV. NO. APROJECT MISSISSIPPI POWER & LIGHT COMPANYBY W.C. SAMPOL DATE FEB. 16, 82SUBJECT GRAND GULF NUCLEAR STATIONCKD Roger Mittl DATE 2/16/82SOLENOID MOUNTING PLATESHEET NO. 45 of 95

14

## PLATE 5" x 1/2"

$$A = 5 \times .25 = 1.25 \text{ IN}^2$$

$$J = R = \frac{1}{12} b d^3 = \frac{1}{12} (5) (.25)^3 = .026 \text{ IN}^4$$

$$I_2 = \frac{5 (.25)^3}{12} = .0065 \text{ IN}^4$$

$$I_3 = \frac{.25 (5)^3}{12} = 2.604$$


$$SF_2 = SF_3 = 0.85$$

$$H_2 = 5.0 \text{ IN}$$

$$H_3 = .25 \text{ IN}$$

$$C_T = 0.25 \text{ IN}$$

$$SSF_2 = SSF_3 = 1.5$$

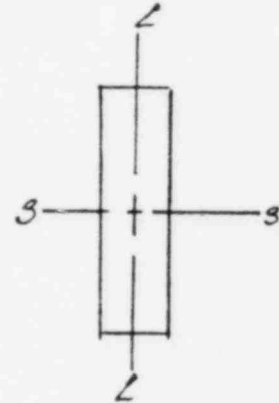





# CALCULATION SHEET

JOB NO. 9645CALC. NO. Q1277, Q2277 REV. NO. APROJECT MISSISSIPPI POWER & LIGHT COMPANYBY Vict. Raupol. DATE FEB. 15 82SUBJECT GRAND GULF NUCLEAR STATIONCKD Roger Mettke DATE 2/16/82SOLENOID MOUNTING PLATESHEET NO. 46 OF 95

15

## PLATE 4 1/2 x 3/8

$$A = 4.25 \times .375 = 1.594 \text{ IN}^2$$

$$I_2 = \frac{1}{12} \times 4.25 \times .375^3 = .01868 \text{ IN}^4$$

$$I_3 = \frac{1}{12} \times .375 \times 4.25^3 = 2.39893 \text{ IN}^4$$

$$J = \beta b d^3 = .313(4.25)(.375)^3 = .07015 \text{ IN}^4$$


$$SF_2 = SF_3 = 0.85$$

$$H_2 = 0.35 \text{ IN}$$

$$H_3 = .375 \text{ IN}$$

$$SSF_2 = SSF_3 = 1.5$$

$$C_1 = 0.375 \text{ IN}$$

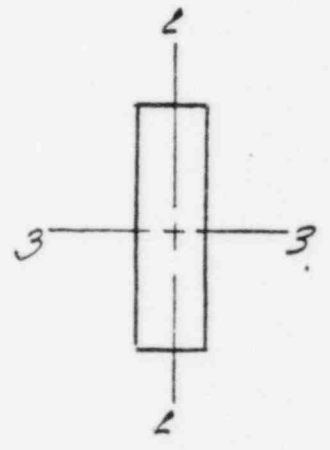



# CALCULATION SHEET

JOB NO. 9645CALC. NO. Q1277, Q2277 REV. NO. APROJECT MISSISSIPPI POWER & LIGHT COMPANYBY Vick. Dwyer DATE FEB 16, 82SUBJECT GRAND GULF NUCLEAR STATIONCKD Grego Mitta DATE 2/14/82SOLENOID MOUNTING PLATESHEET NO. 47 OF 95

16

PLATE 3 1/2 X 3/8

$$A = 3.5 \times .375 = 1.3125 \text{ IN}^2$$

$$I_2 = \frac{1}{12} \times 3.5 \times .375^3 = .01538 \text{ IN}^4$$

$$I_3 = \frac{1}{12} \times .375 \times 3.5^3 = 1.3398 \text{ IN}^4$$

$$J = B b d^3 = .311 \times 3.5 \times .375^3 = .0574 \text{ IN}^4$$


$$C_{TOR} = .375 \text{ IN}$$

$$H_2 = 3.5 \text{ IN}$$

$$H_3 = .375 \text{ IN}$$

$$SF_2 = SF_3 = 0.85$$

$$SSF_1 = SSF_2 = 1.5$$

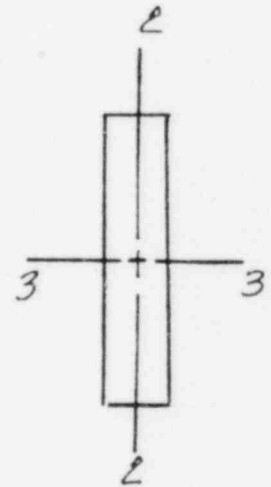




# CALCULATION SHEET

JOB NO. 9645CALC. NO. Q1277, Q2277REV. NO. APROJECT MISSISSIPPI POWER & LIGHT COMPANYBY B. MettsDATE 2/16/82SUBJECT GRAND GULF NUCLEAR STATIONCKD [Signature]DATE 2/16/82SOLENOID MOUNTING PLATESHEET NO. 43 OF 95

17

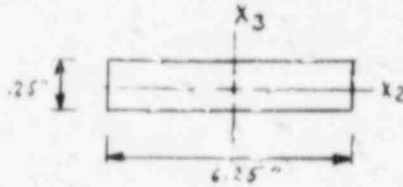PLATE  $6\frac{1}{4} \times \frac{1}{4}$ 

$$A = (.25 \text{ in}) (6.25 \text{ in}) = 1.563 \text{ in}^2$$

$$J = (.333) (6.25 \text{ in}) (.25 \text{ in})^3 = .033 \text{ in}^4 \quad (\text{R from DESIGN OF WELDED STRUCTURES})$$

$$I_3 = (.25 \text{ in}) (6.25 \text{ in})^3 / 12 = 5.086 \text{ in}^4$$

$$I_2 = (6.25 \text{ in}) (.25 \text{ in})^3 / 12 = .008 \text{ in}^4$$

$$SF_2 = SF_3 = 0.85 \quad (\text{Recommended Value from manual})$$

$$H_3 = 0.25 \text{ in} \quad H_2 = 6.25 \text{ in}$$

$$CTORS = 0.25$$


$$SSF_2 = SSF_3 = 1.50 \quad (\text{Recommended Value from manual})$$



# CALCULATION SHEET

JOB NO. 9695CALC NO. Q1277, Q2277REV. NO. APROJECT MISSISSIPPI POWER & LIGHT COMPANYBY J MattheDATE 2/16/82SUBJECT GRAND GULF NUCLEAR STATIONCKD [Signature]DATE 2/16/82SOLENOID MOUNTING PLATESHEET NO. 49 of 95

18

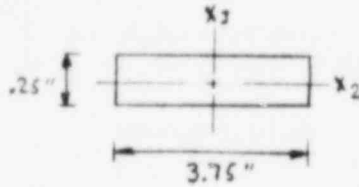PLATE  $3\frac{3}{4} \times \frac{1}{4}$ 

$$A = (.25 \text{ in})(3.75 \text{ in}) = 0.938 \text{ in}^2$$

$$J = (.333)(3.75 \text{ in})(.25 \text{ in})^3 = 0.020 \text{ in}^4$$

$$I_3 = (.25)(3.75 \text{ in})^3 / 12 = 1.099 \text{ in}^4$$

$$I_2 = (3.75 \text{ in})(.25 \text{ in})^3 / 12 = 0.005 \text{ in}^4$$

$$SF_2 = SF_3 = 0.85 \quad (\text{Recommended value from manual})$$

$$H_3 = 0.25 \text{ in} \quad H_2 = 3.75 \text{ in}$$

$$CTORS = .25$$

$$SFF_2 = SFF_3 = 1.50 \quad (\text{Recommended value from manual})$$



# CALCULATION SHEET

JOB NO. 9645

CALC. NO. 91277, 92277 REV. NO. A

PROJECT MISSISSIPPI POWER & LIGHT COMPANY

BY Nick Noyes DATE FEB 18 82

SUBJECT GRAND GULF NUCLEAR STATION

CKD Stephen R. Descoteaux DATE 2/19/82

SOLENOID MOUNTING PL.

SHEET NO. 50 of 95

19

Ø 6" x 3/8"

$$A = 6 \times .375 = 2.25 \text{ in}^2$$

$$J = \frac{1}{12} b d^3 = .333(6)(.375)^3 = .1050 \text{ in}^4$$

$$I_2 = \frac{1}{12} (6)(.375)^3 = .0260 \text{ in}^4$$

$$I_3 = \frac{1}{12} (.375)(6)^3 = 6.75 \text{ in}^4$$


$$SF_2 = SF_3 = .85$$

$$H_2 = 6''$$

$$H_3 = .375''$$

$$SSF_2 = SSF_3 = 1.5$$

$$CTOR = .375''$$

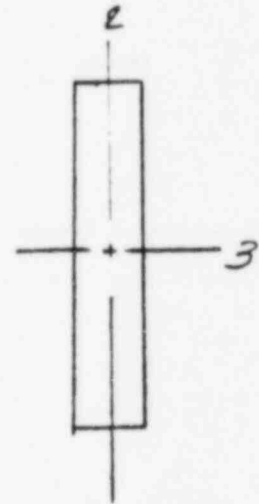



# CALCULATION SHEET

JOB NO. 9645CALC. NO. Q1277, Q2777 REV. NO. APROJECT MISSISSIPPI POWER & LIGHT COMPANYBY Ray Muth DATE 2/22/82SUBJECT GRAND GULF NUCLEAR STATIONCKD Bill - Raypy DATE FEB 22, 82SOLENOID MOUNTING PLATESHEET NO. 51 of 95

20

 $4 \times 3 \times 3 \times 1/4$ 

$$A = 1.44 \text{ in}^2$$

$$J = 2 F b d^3 = (2)(303)(3)(.25)^3 = .031 \text{ in}^4$$

$$I_{2-2} = I_{3-3} = 1.24 \text{ in}^4$$


$$SF_2 = SF_3 = \frac{(3)(.25)}{1.44} = .521$$

$$H_2 = H_3 = 9.316 \text{ in}$$

$$CTORS = .25 \text{ in}$$

$$\theta_2 = \theta_3 = \frac{(.25)(-158)}{2} = .582$$

$$SSF_2 = SSF_3 = \frac{(.582)(1.44)}{(1.24)(.25)} = 2.704$$

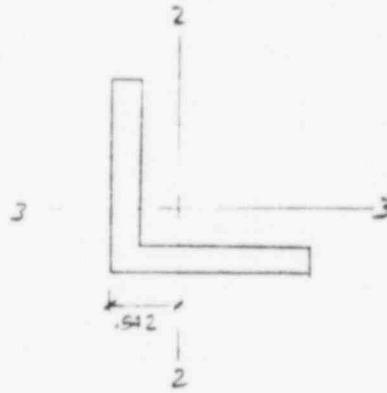



# CALCULATION SHEET

JOB NO. 9645CALC. NO. Q1277, Q2277 REV. NO. APROJECT MISSISSIPPI POWER & LIGHT COMPANYBY C. A. Naypy DATE FEB. 18. 82SUBJECT GRAND GULF NUCLEAR STATIONCKD W. J. Mettler DATE 2/24/82SOLENOID MOUNTING PL.SHEET NO. 52 OF 95

## SECTION PROP.

E1	E2
----	----

COMPOSITE MEMBER OF 2L4x3/8 & 1/2x1/2x1/2

CG OF  $1/2 \times 1/2 \times 1/2$ ;  $x = .466$ "  
 $A_f = .688 \text{ in}^2$ ,  $A_L = 1.5 \text{ in}^2$   
 $A_{TOT} = 2.188 \text{ in}^2$

CG OF COMBINATION,  $M$  &  $N$ .

$$M = \frac{.688(1/2 \times .466) + 1.5(2.0)}{2.188} = 1.930 \text{ in}$$

$$n = \frac{.688(3/8 + .466) + 1.5(3/16)}{2.188} = .393 \text{ in}$$

$$J = \sum \beta b d^3$$

$$\approx 2(.299 \times 1.5 \times .25^3) + (.913 \times 0 \times .375^3)$$

$$= .080 \text{ in}^4$$

$$I_2 = \frac{1}{12}(4 \times .375^3) + 1.5(.393 - 3/16)^2 + .139 + .688(.466 + 3/8 - .393)^2$$

$$= .358 \text{ in}^4$$

$$I_3 = \frac{1}{12}(.375 \times 4)^3 + 1.5(2.0 - 1.930)^2 + .139 + .688(1.930 - 1/2 - .466)^2$$

$$= .162 \text{ in}^4$$


$$C_{TOR} = .375 + .25 = .625 \text{ in}$$

$$H_2 = 2(0.75) = 1.5 \text{ in}$$

$$H_3 = 2(1.5 + .375 - .75) = 2.25 \text{ in}$$

$$SF_2 = \frac{(1.5 + .375) \cdot .25}{2.188} = .214$$

$$SF_3 = \frac{(1.5 \times .25) + (0 \times .375)}{2.188} = .857$$

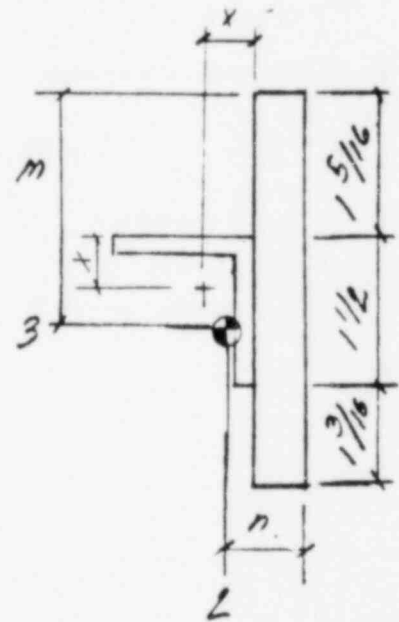



# CALCULATION SHEET

JOB NO. 9645

CALC. NO. Q1277, Q2777 REV. NO. A

PROJECT MISSISSIPPI POWER & LIGHT COMPANY

BY Orin Kaypool DATE 12/18/82

SUBJECT GRAND GULF NUCLEAR STATION

CKD Angelo Motta DATE 2/24/82

SOLENOID MOUNTING 12


SHEET NO. 53 OF 95

$$Q_2 = 1.5 (.393 - \frac{3}{16}) + 1.5 (.018) \frac{2}{2} = .3085 \text{ in}^3$$

$$Q_3 = \frac{.375 (.07)^2}{2} + \frac{.25 (.8825)^2}{2} = .9008 \text{ in}^3$$

$$SSF_2 = \frac{.3085 \times 2.188}{.318 \times .25} = 7.542$$

$$SSF_3 = \frac{.9008 \times 2.188}{.2162 \times (.25 + .375)} = 1.459$$

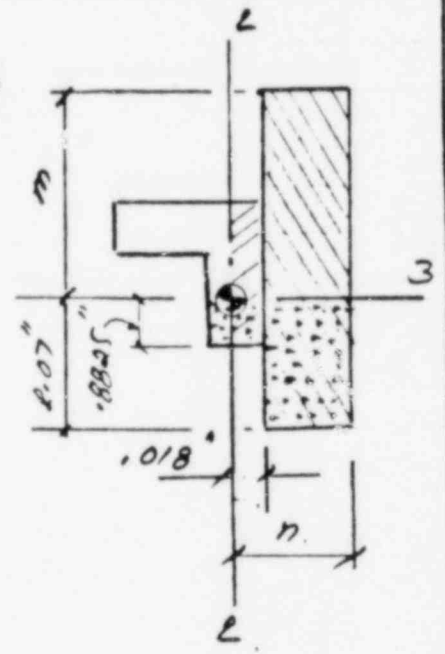






# CALCULATION SHEET

JOB NO. 9645CALC NO. Q1277, Q2277 REV. NO. APROJECT MISSISSIPPI POWER & LIGHT COMPANYBY Vic4. Naypy. DATE FEB 28 82SUBJECT GRAND GULF NUCLEAR STATIONCKD Stephen A. Descoteaux DATE 2/24/82SOLENOID MOUNTING R.SHEET NO. 54 OF 95

23

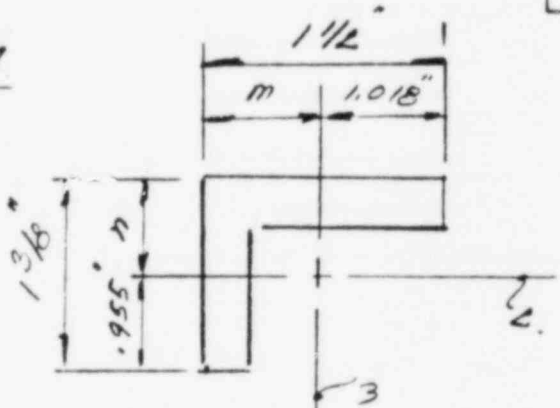1 1/2 x 1 3/8 x 1/4

$$A = .25[1.375 + (1.5 - .25)] = .6563 \text{ in}^2$$

$$J = \sum \beta b d^3 = .2905(1.375)(.25)^3 + .290(1.25)(.25)^3 = .0120 \text{ in}^3$$

$$N.A. \quad m = \frac{1.375(.25)^2 + 1.25(1.25)(.875)}{.6563}$$

$$= .482 \text{ in}$$

$$I_1 = \frac{.25(1.375)^3 + 1.25(.25)^3}{.6563} = .420 \text{ in}^4$$

$$I_2 = \frac{1}{12}(.25)(1.375)^3 + (1.375 \times .25)(\frac{1.375}{2} - .420)^2 + \frac{1}{12}(.25)(.25)^3 + 1.25(.25)(.420 - \frac{.25}{2})^2 = .1076 \text{ in}^4$$

$$I_3 = \frac{1}{12}(.25)(1.375)^3 + (1.375 \times .25)(.482 - \frac{.25}{2})^2 + \frac{1}{12}(.25)(1.25)^3 + (1.25 \times .25)(.018 - \frac{.25}{2})^2 = .1346 \text{ in}^4$$

$$C_{70R} = .25 \text{ in}$$

$$M_2 = 2 \times 1.018 = 2.036 \text{ in}$$

$$M_3 = 2 \times .955 = 1.910 \text{ in}$$

$$SF_2 = \frac{1.375 \times .25}{.6563} = .524$$

$$SF_3 = \frac{1.5 \times .25}{.6563} = .571$$



# CALCULATION SHEET

JOB NO. 9645  
PROJECT MISSISSIPPI POWER & LIGHT COMPANY  
SUBJECT GRAND GULF NUCLEAR STATION  
SOLENOID MOUNTING TB

CALC. NO. Q1277, Q2277 REV. NO. A  
BY W.C. Naypy DATE FEB 22, 82  
CKD Stephen A. Descoteaux DATE 2/24/82  
SHEET NO. 55 OF 95

$$SSF_2 = \frac{(.25 (1.955)^2 \times 1/2) \times .6563}{.1076 \times .25} = 2.781$$

$$SSF_3 = \frac{(.25 (1.018)^2 \times 1/2) \times .6563}{.1346 \times .25} = 2.527$$



# CALCULATION SHEET

JOB NO. 9645CALC. NO. Q1277, Q2277 REV. NO. APROJECT MISSISSIPPI POWER & LIGHT COMPANYBY W. D. Damp DATE FEB 22, 82SUBJECT GRAND GULF NUCLEAR STATIONC.I.D. J. G. Watts DATE 2/25/82SOLENOID MOUNTING PLSHEET NO. 56 OF 95

24

PL 1/4" x 5 1/2"

$$A = .25 \times 5.5 = 1.375 \text{ in}^2$$

$$J = .333(5.5)(.25)^3 = .0286 \text{ in}^4$$

$$I_2 = \frac{1}{12}(5.5)(.25)^3 = .0072 \text{ in}^4$$

$$I_3 = \frac{1}{12}(.25)(5.5)^3 = 3.066 \text{ in}^4$$


$$C_{10R} = .25 \text{ "}$$

$$h_2 = 5.5 \text{ "}$$

$$h_3 = .25 \text{ "}$$

$$S F_2 = S F_3 = .85$$

$$SS F_2 = SS F_3 = 1.5$$

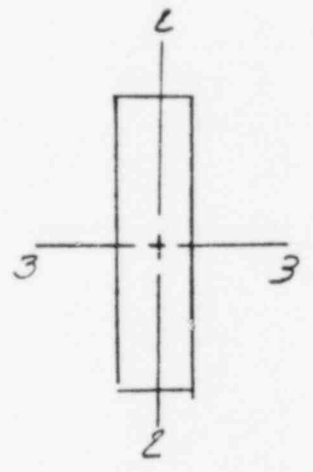



# CALCULATION SHEET

JOB NO. 9605

CALC. NO. Q1777, Q2377 REV. NO. A

PROJECT MISSISSIPPI POWER & LIGHT COMPANY

BY Virel. Rampy DATE FEB 23, 82

SUBJECT GRAND GULF NUCLEAR STATION

CKD Stephen A. Descoteaux DATE 2/24/82

SOLENOID MOUNTING R

SHEET NO. 57 OF 95

25

R 1/4 x 1 1/2

$$A = .25 \times 1.5 = .375 \text{ IN}^2$$

$$J = .299 (1.5 \times .25)^3 = .007 \text{ IN}^4$$

$$I_2 = \frac{1}{12} (1.5)(.25)^3 = .002 \text{ IN}^4$$

$$I_3 = \frac{1}{12} (.25)(1.5)^3 = .070 \text{ IN}^4$$


$$SF_2 = SF_3 = .85$$

$$H_2 = 1.5 \text{ ''}$$

$$H_3 = .25 \text{ ''}$$

$$C_{TOR} = .25 \text{ ''}$$

$$SSF_2 = SSF_3 = 1.5$$

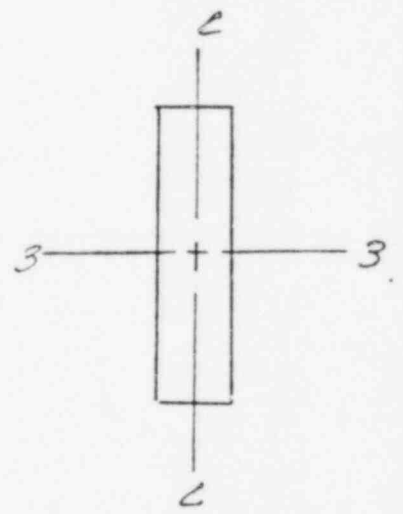



# CALCULATION SHEET

JOB NO. 9625CALC. NO. Q1277, Q2277 REV. NO. APROJECT MISSISSIPPI POWER & LIGHT COMPANYBY V. S. DAPPY DATE FEB 19 82SUBJECT GRAND GULF NUCLEAR STATIONCKD Stephen A. Descoteaux DATE 2/19/82SOLENOID MOUNTING R.SHEET NO. 58 OF 95

26

4 x 1/4

$$A = 4 \times .25 = 1.0 \text{ in}^2$$

$$J = .933(4)(.25)^3 = .0208 \text{ in}^4$$

$$I_2 = \frac{1}{12}(4)(.25)^3 = .0052 \text{ in}^4$$

$$I_3 = \frac{1}{12}(.25)(4)^3 = 1.333 \text{ in}^4$$


$$C_{TOR} = .25 \text{ in}$$

$$H_2 = 4 \text{ in}$$

$$H_3 = .25 \text{ in}$$

$$SF_2 = SF_3 = .85$$

$$SSF_2 = SSF_3 = 1.5$$

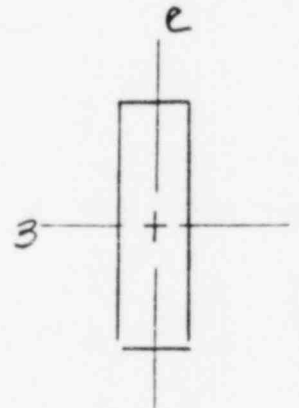



# CALCULATION SHEET

JOB NO. 9645

CALC. NO. Q1277, Q2277 REV. NO. A

PROJECT GRAND GULF STATION

BY [Signature] DATE 3/8/82


SUBJECT Q1277FOOZA

CKD James H. Callahan DATE 3/10/82


FCN - M - 1146

SHEET NO. 59 OF 95


## WELD PROFILES

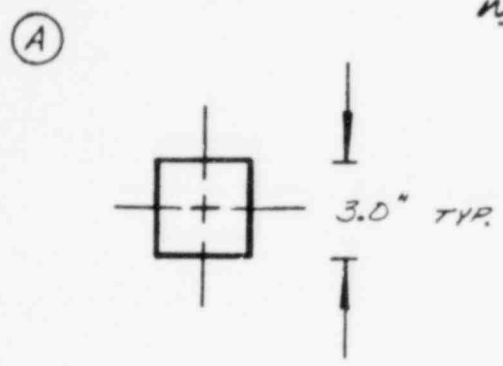


- \* AT SUPPORT POINT - ITEM 1
- \* 3/16" FILLET - ALL AROUND

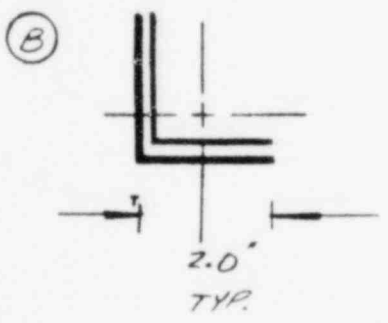

- \* ITEM 2 - ITEM 1
- \* 3/16" FILLET - ALL AROUND

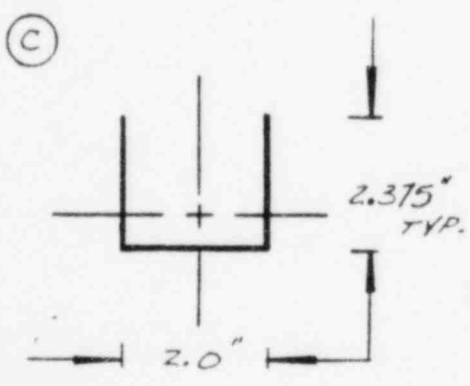

- \* ITEM 3 - ITEM 2
- \* 3/16" FILLET - 3 SIDES

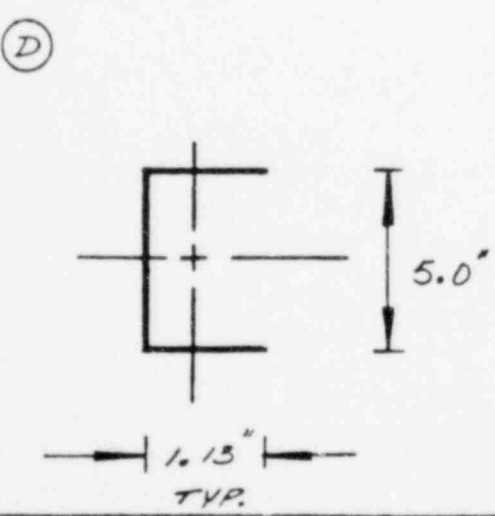

- \* ITEM 5 - SOLENOID FL
- \* 3/16" FILLET - 3 SIDES



# CALCULATION SHEET

JOB NO. 9645

CALC NO. Q1277, Q2277

REV. NO. A

PROJECT GRAND COULE STATION

BY *[Signature]*

DATE 3/3/82


SUBJECT Q1277F003A

CKD *[Signature]*


DATE 3/10/82

FCN-M-1149


SHEET NO. 60 OF 95

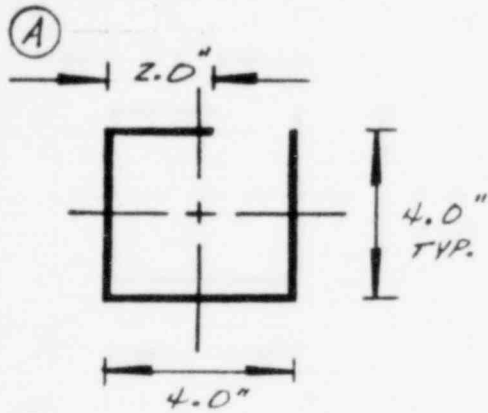


\* ITEM 1 - EXISTING SUPPORT  
 \* 3/16" FILLET - ALL AROUND LESS 2"

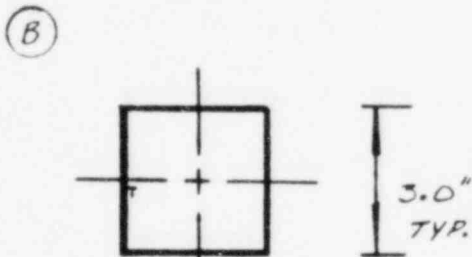


\* ITEM 1 - ITEM 2  
 \* 3/16" FILLET - ALL AROUND

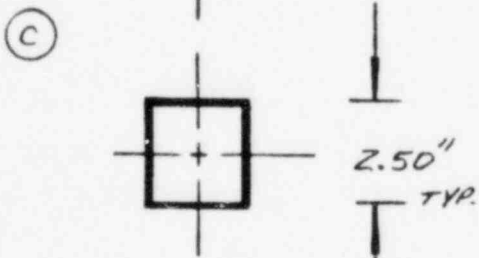

\* ITEM 2 - ITEM 3  
 \* 3/16" FILLET - ALL AROUND

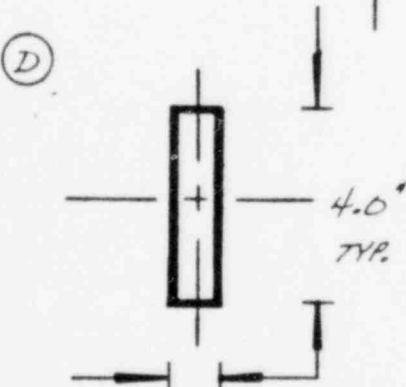

\* ITEM 4 - ITEM 3  
 \* 3/16" FILLET - ALL AROUND

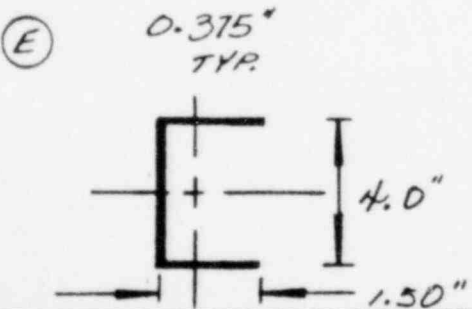

\* ITEM 4 - SOLENOID FE  
 \* 3/16" FILLET - 3 SIDES  
 \* 1.50" ASSUMED - DUE TO INFORMATION SUPPLIED



# CALCULATION SHEET

JOB NO. 9645

CALC. NO. Q1277, Q2277

REV. NO. A

PROJECT GRAND GULF STATION

BY *[Signature]*

DATE 3/8/82

SUBJECT Q2277F001A


CKD James H. Allyn

DATE 3/10/82

FCN-M-1140


SHEET NO. 61 OF 95

(A)

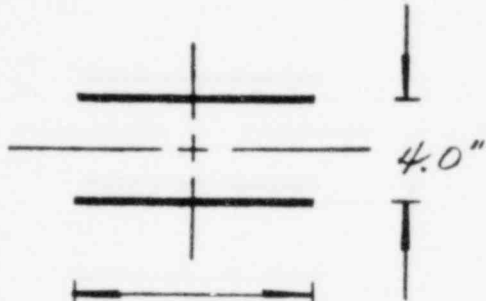


\* ITEM 1 - EXISTING SUPPLY  
 \* 1/4" FILLET + FLARE BEVEL

(B)

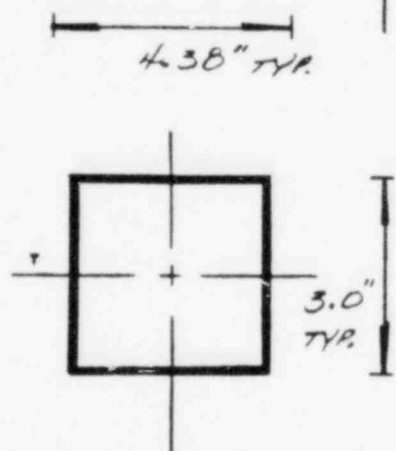


\* ITEM 1 - ITEM 2  
 \* 3/16" FILLET - ALL AROUND

(C)

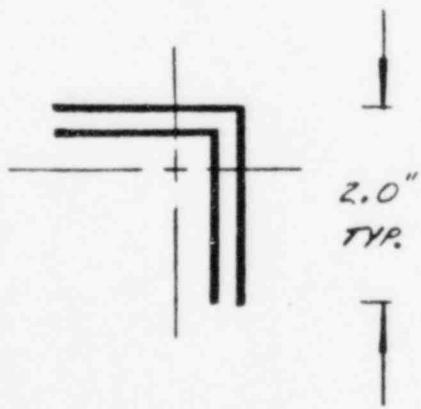

\* ITEM 2 - ITEM 4  
 \* 3/16" FILLET - ALL AROUND

(D)

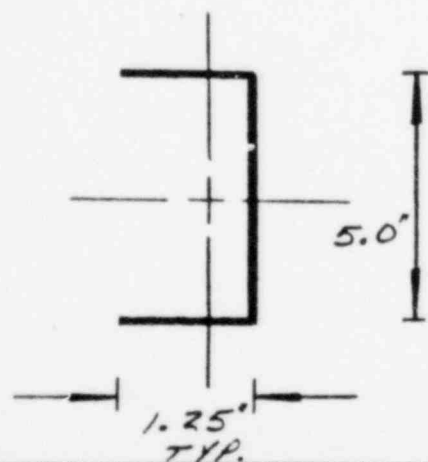

\* ITEM 3 - SOLENOID #  
 \* 3/16" FILLET - 3 SIDES





# CALCULATION SHEET

JOB NO. 9645

CALC. NO. Q1277, Q2277

REV. NO. A

PROJECT GRAND GULF STATION

BY [Signature]

DATE 3/8/82

SUBJECT Q1277F002B


CKD James F. Kelly

DATE 3/10/82

FCN-M-1147

SHEET NO. 62 OF 95

(A)

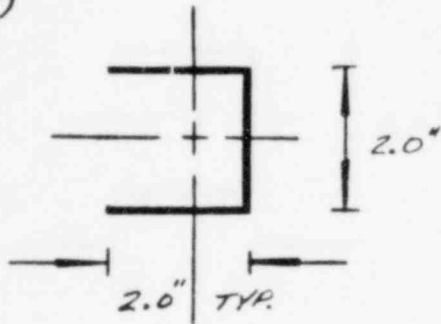


- \* ITEM 1 - EXISTING SUPPORT
- \* 3/16" FILLET - 3 SIDES

(B)




- \* ITEM 1 - ITEM 2
- \* 3/16" FILLET - ALL AROUND

(C)

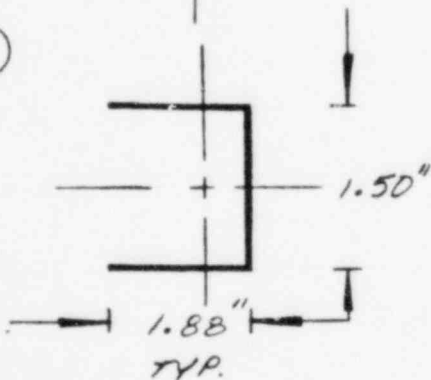

- \* ITEM 2 - ITEM 3
- \* 3/16" FILLET - 3 SIDES

(D)

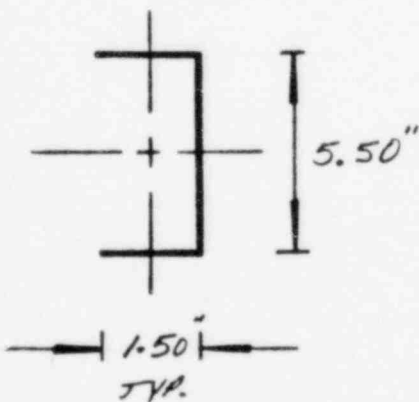

- \* ITEM 4 - SOLENOID FE
- \* 3/16" FILLET - 3 SIDES



# CALCULATION SHEET

JOB NO. 9645

CALC NO. Q1277, Q2277

REV. NO. A

PROJECT GRAND GULF STATION

BY [Signature]

DATE 5/8/82

SUBJECT Q1277 F035A


CKD James H. Kelly

DATE 3/10/82

FCN-M-1151


SHEET NO. 63 OF 95

(A)

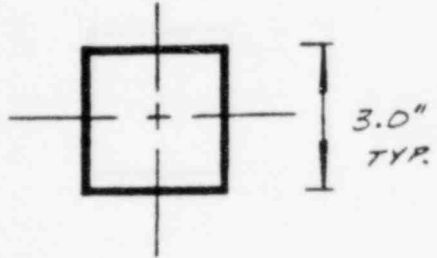


- \* TUBING STEEL -
- EXISTING SUPPORT
- \* 3/16" FILLET - ALL AROUND

(B)

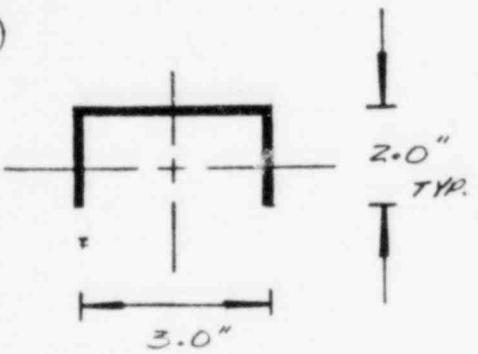

- \* 2" x 2" x 1/4" - TS 3x3x1/4
- \* 3/16" FILLET + FLARE BEVEL
- 3-SIDES - 2 SIDES

(C)

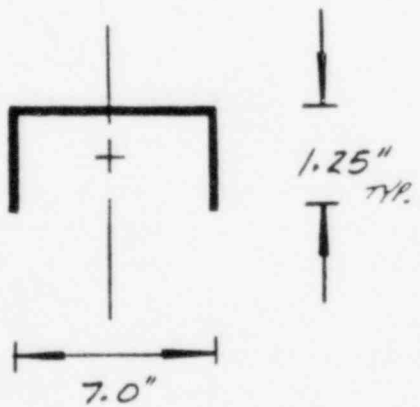

- \* 2" x 1 1/2" x 1/4" - SOLERID
- FE
- \* 3/16" FILLET - 3 SIDES



# CALCULATION SHEET

JOB NO. 9645

CALC. NO. Q1277, Q2277

REV. NO. A

PROJECT GRAND GULF STATION

BY [Signature]

DATE 3/18/82

SUBJECT Q1277F003B


CKD James Walsh

DATE 3/19/82

FCN - M - 1144


SHEET NO. 64 OF 95

(A)

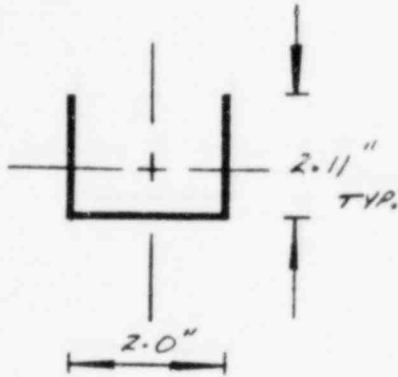


- \* ITEM 1 - EXISTING ANGLE
- \* 3/16" FILLET - 3 SIDES  
(CONSERV. PROFILE SHOWN)

(B)

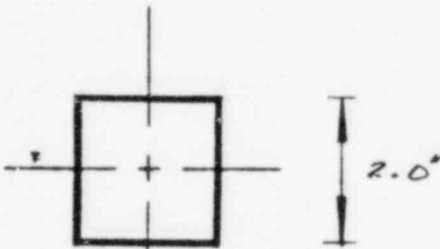


- \* ITEM 1 - ITEM 2
- \* 3/16" FILLET - ALL AROUND

(C)

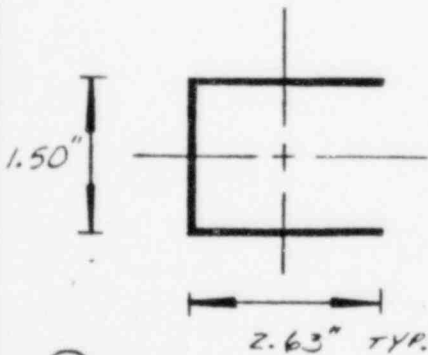

- \* ITEM 3 - ITEM 4
- \* 3/16" FILLET - 3 SIDES

(D)

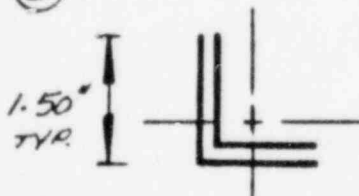

- \* ITEM 2 - ITEM 5
- \* 3/16" FILLET - ALL AROUND

(E)



- \* ITEM 6 - SOLENOID PLATE
- \* 3/16" FILLET - 3 SIDES



# CALCULATION SHEET

JOB NO. 9645

CALC. NO. Q1277, Q2277

REV. NO. A

PROJECT GRAND GULF STATION

BY [Signature]

DATE 3/8/82

SUBJECT Q2277F035B


CKD James D. Kelly

DATE 3/10/82

FCN-M-1141


SHEET NO. 65 OF 95

(A)

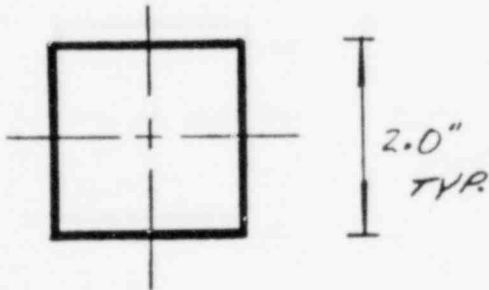


- \* ITEM 1 - EXISTING SUPPORT
- \* 3/16" FILLET - ALL AROUND

(B)

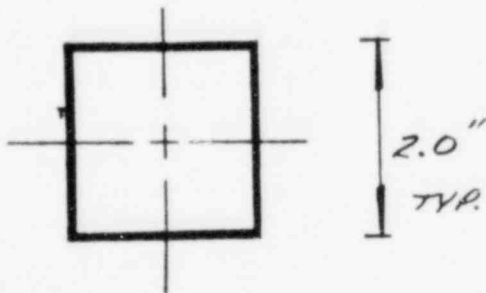

- \* ITEM 1 - ITEM 3
- \* 3/16" FILLET - ALL AROUND

(C)

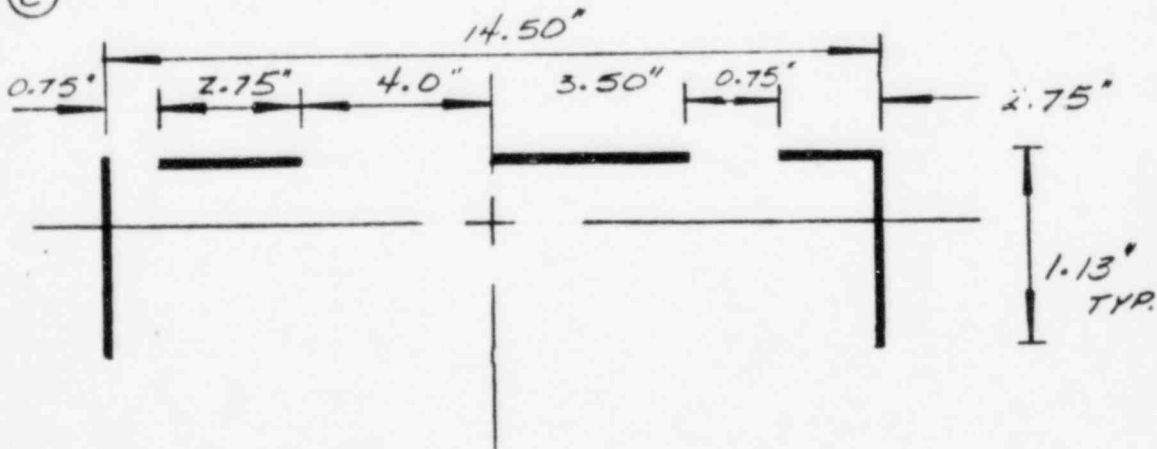

- \* ITEM 2 - SOLENOID  $\phi$
- \* 3/16" FILLET - AS SHOWN



# CALCULATION SHEET

JOB NO. 9645

CALC. NO. Q1277, Q2277

REV. NO. A

PROJECT GRAND GULF STATION

BY [Signature]

DATE 3/8/82

SUBJECT Q2277F001B


CKD James Kelly

DATE 3/10/82

FCN-M-1139

SHEET NO. 66 OF 95

(A)

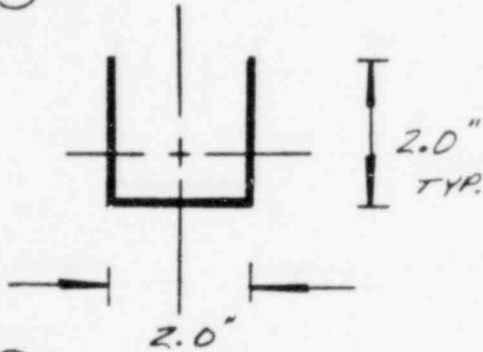


- \* ITEM 1 - EXISTING SUPPORT
- \* 3/16" FILLET - 3 SIDES

(B)




- \* ITEM 1 - ITEM 2
- \* 3/16" FILLET - ALL AROUND

(C)

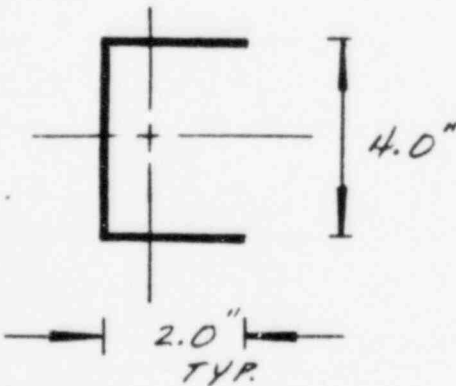

- \* ITEM 5 - ITEM 4
- \* 3/16" FILLET - 3 SIDES

(D)

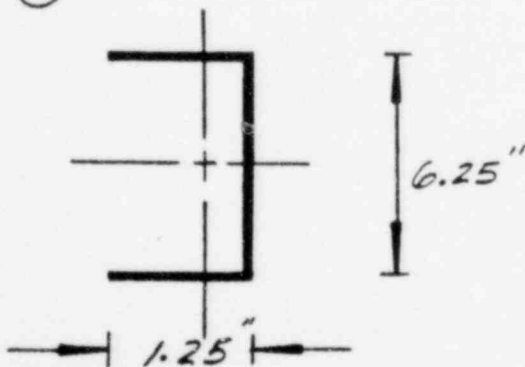

- \* ITEM 4 - SOLENOID #
- \* 3/16" FILLET - 3 SIDES



# CALCULATION SHEET

JOB NO. 9645

CALC. NO. Q1277, Q2277 REV. NO. A

PROJECT GRAND GULF STATION


BY [Signature] DATE 3/10/82

SUBJECT Q2277F035A  
FCN-MA-1152

CKD [Signature] DATE 3/10/82


SHEET NO. 67 OF 95

(A)

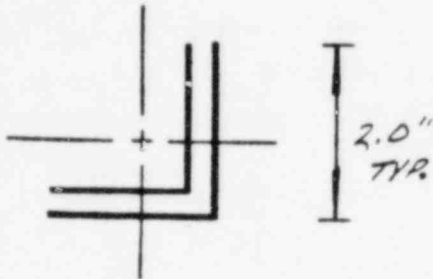


- \* ITEM 1 - EXISTING SUPPORT
- \* 3/16" FILLET - ALL AROUND

(B)

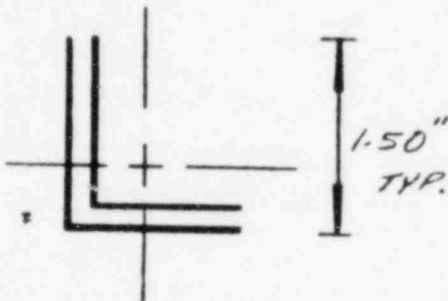


- \* ITEM 1 - ITEM 2
- \* 3/16" FILLET - ALL AROUND

(C)

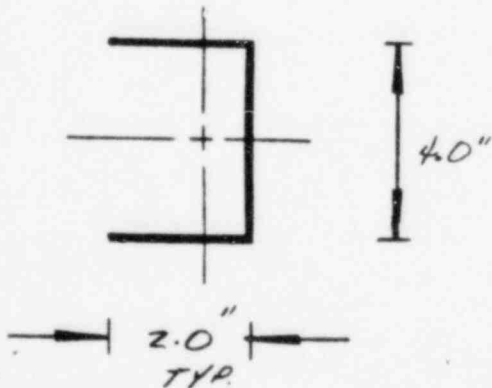

- \* ITEM 2 - ITEM 3
- \* 3/16" FILLET - 3 SIDES

(D)

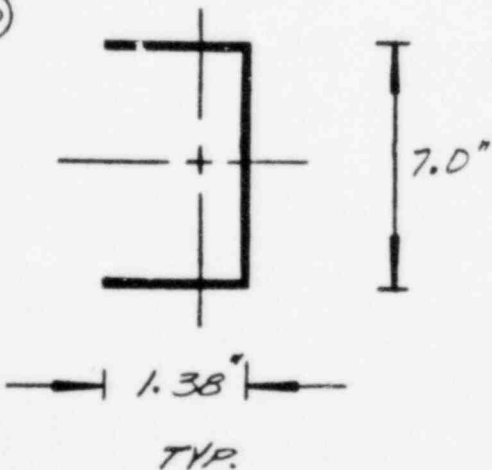

- \* ITEM 4 - SOLENOID FE
- \* 3/16" FILLET - 3 SIDES



# CALCULATION SHEET

JOB NO. 9645

CALC NO. Q1277, Q2277 REV. NO. A

PROJECT GRAND GULF STATION

BY [Signature] DATE 3/8/82


SUBJECT Q1277F001B

CKD James H. Calyn DATE 3/10/82

FCN-M-1138


SHEET NO. 68 OF 95

(A)

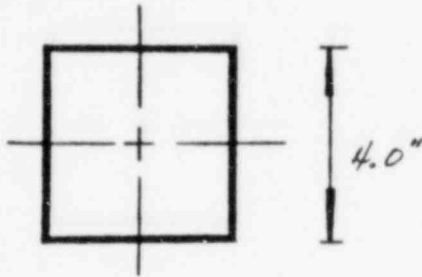


- \*  $754 \times 4 \times 1/4$  - BASE PL
- \*  $3/16$ " FILLET - ALL AROUND

(B)

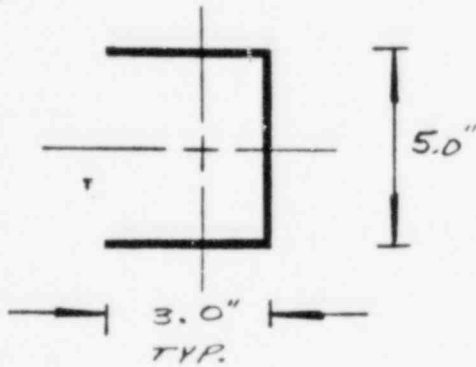

- \*  $3 \times 3 \times 1/4$  -  $1 1/2 \times 2 \times 1/4$
- \*  $3/16$ " FILLET - 3 SIDES

(C)

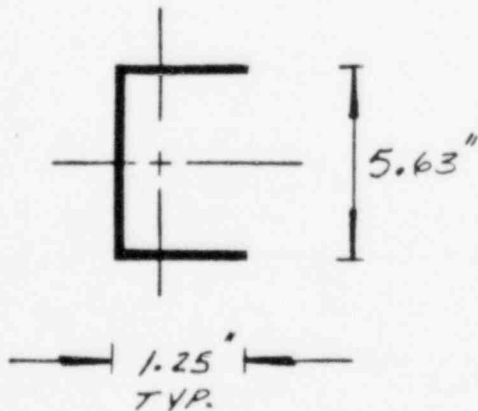

- \*  $1 1/2 \times 2 \times 1/4$  - SOLENOID PL
- \*  $3/16$ " FILLET - 3 SIDES



# CALCULATION SHEET

JOB NO. 9645

CALC. NO. Q2277, Q2277

REV. NO. A

PROJECT CORRAL GOLF STATION

BY [Signature] DATE 3/8/82


SUBJECT Q2277F003A

CKD James H. Callahan DATE 3/10/82

FCU-M-1150


SHEET NO. 69 of 95

(A)

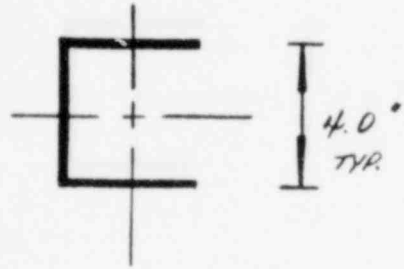


- \* ITEM 1 - EXISTING SUPPORT
- \* 3/16" FILLET - 3 SIDES

(B)

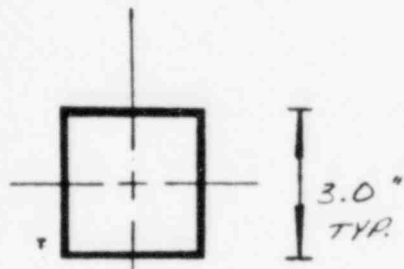


- \* ITEM 2 - ITEM 1
- \* 3/16" FILLET - ALL AROUND

(C)

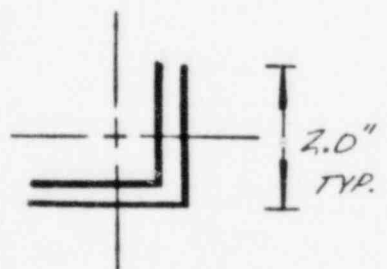


- \* ITEM 3 - ITEM 2
- \* 3/16" FILLET - ALL AROUND

(D)

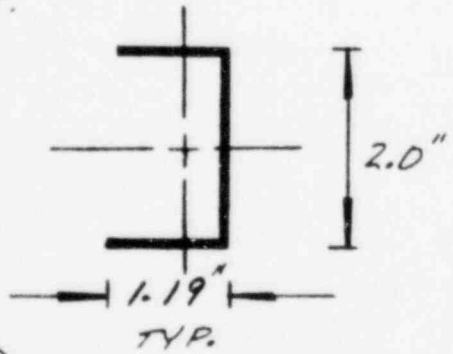

- \* ITEM 3 - ITEM 4
- \* 3/16" FILLET - 3 SIDES

(E)

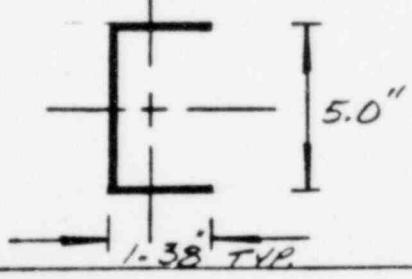

- \* ITEM 5 - SOLENOID FE
- \* 3/16" FILLET - 3 SIDES





# CALCULATION SHEET

JOB NO. 9645

CALC. NO. Q1277, Q2277 REV. NO. A

PROJECT GRAND GULF STATION

BY [Signature] DATE 3/8/02


SUBJECT Q2277FOO2A

CKD James H. Callahan DATE 3/10/02

FCN-M-1145

SHEET NO. 70 of 95

(A)

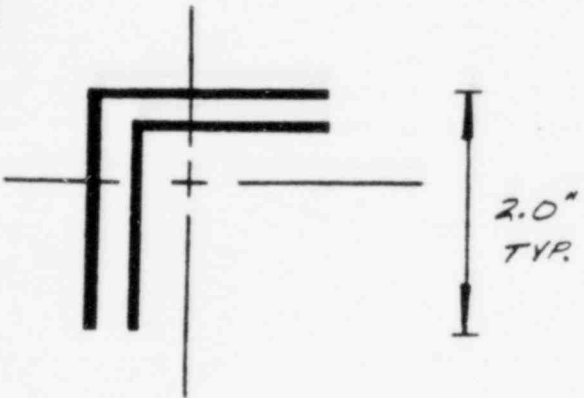

- \* ITEM 1 - SOLENOID #
- \* 5/16" FILLET - ALL AROUND



# CALCULATION SHEET


JOB NO. 9645 CALC. NO. Q1277, Q2277 REV. NO. A

PROJECT GRAND GULF STATION BY [Signature] DATE 3/8/82

SUBJECT Q2277F003E CKD James H. Callahan DATE 3/10/82


FCN-M-1143 SHEET NO. 21 OF 95

(A)

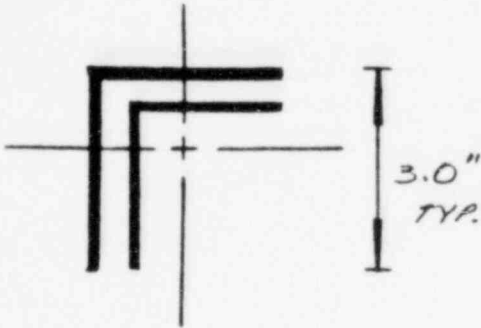


- \* ITEM 1 - EXISTING SUPPORT
- \* 3/16" FILLET - ALL AROUND

(B)

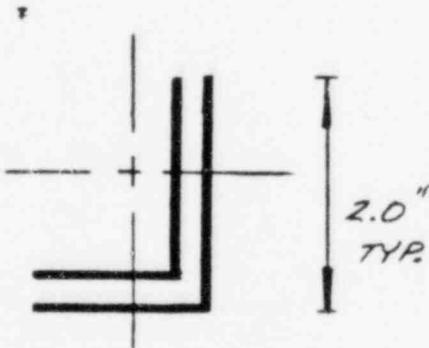

- \* ITEM 2 - ITEM 1
- \* 3/16" FILLET - ALL AROUND

(C)

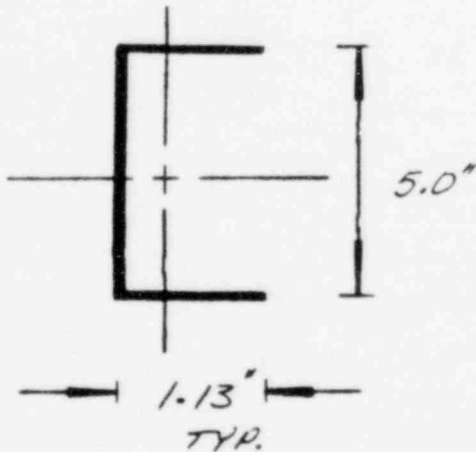

- \* ITEM 3 - SOLENOID FL
- \* 3/16" FILLET - 3 SIDES



# CALCULATION SHEET

JOB NO. 9645

CALC NO. Q1277, Q2277 REV. NO. A

PROJECT GRAND GULF STATION

BY [Signature] DATE 3/8/82


SUBJECT Q1277F035B

CKD James H. Kelly DATE 3/10/82

FCN-M-1142


SHEET NO. 72 OF 95

(A)

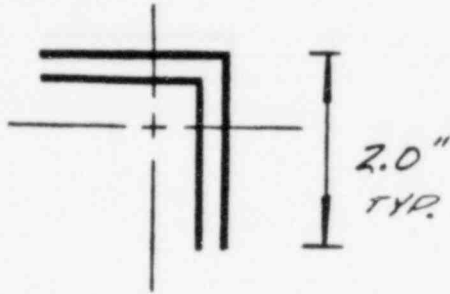


- \* ITEM 1 - EXISTING SUPPORT
- \* 3/16" FILLET - ALL AROUND

(B)

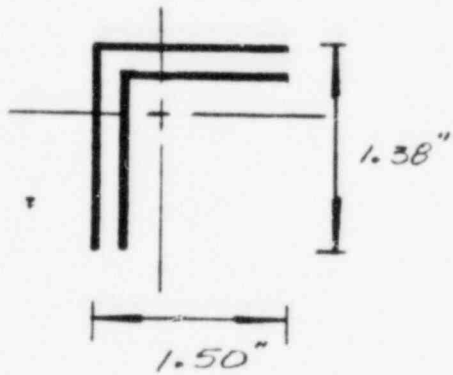

- \* ITEM 1 - ITEM 2.
- \* 3/16" FILLET - ALL AROUND

(C)

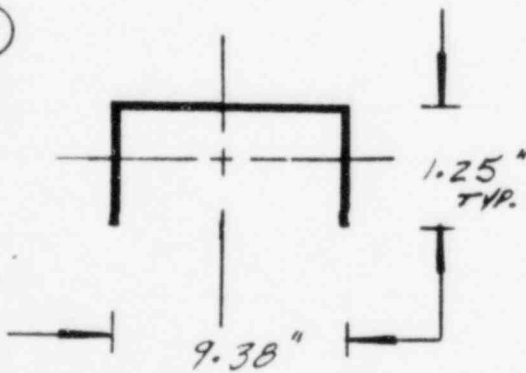

- \* ITEM 3 - SOLENOID FE
- \* 3/16" FILLET - 3 SIDES



# CALCULATION SHEET


JOB NO. 9645 CALC. NO. Q1277, Q2277 REV. NO. A

PROJECT GRAND GULF STATION BY [Signature] DATE 3/8/82

SUBJECT Q1277F001A CKD James J. Callahan DATE 3/14/82


FCN-M-1137 SHEET NO. 73 OF 95

(A)

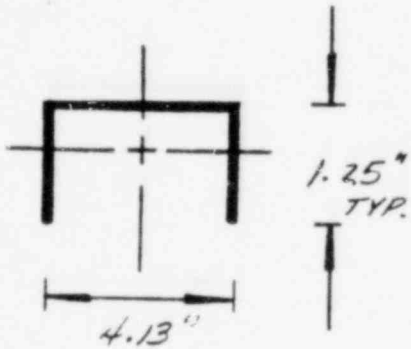


- \* ITEM 3 - ITEM 2
- \* 3/16" - FILLET - 3 SIDES

(B)

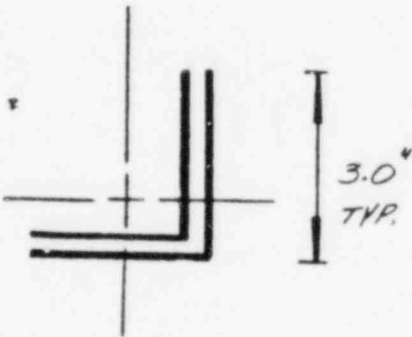

- \* ITEM 2 - ITEM 1
- \* 3/16" FILLET - ALL AROUND

(C)

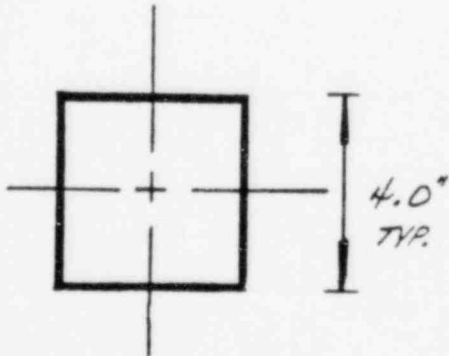

- \* ITEM 1 - EXISTING SUPPORT
- \* 3/16" FILLET - ALL AROUND



# CALCULATION SHEET

JOB NO. 9645

CALC. NO. Q2277, Q2277

REV. NO. A

PROJECT GRAND GULF STATION

BY [Signature]

DATE 3/8/82

SUBJECT Q2277F002B


CKD James Hollyn

DATE 3/10/82

FCN-M-1148


SHEET NO. 74 of 95

(A)

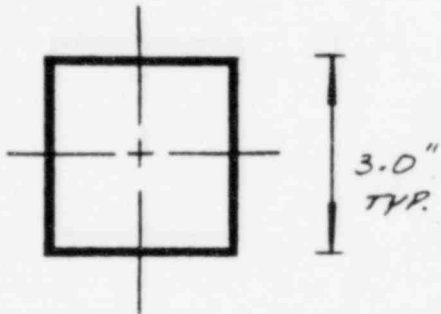


- \* ITEM 2 - BOLTED  $\#$
- \*  $1/4$ " FILLET - ALL AROUND

(B)

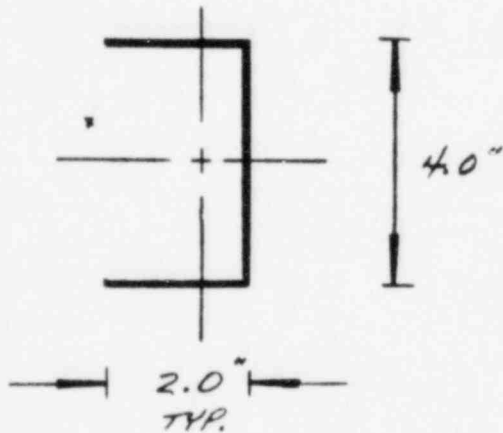

- \* ITEM 3 - ITEM 2
- \*  $3/16$ " FILLET - 3 SIDES

(C)

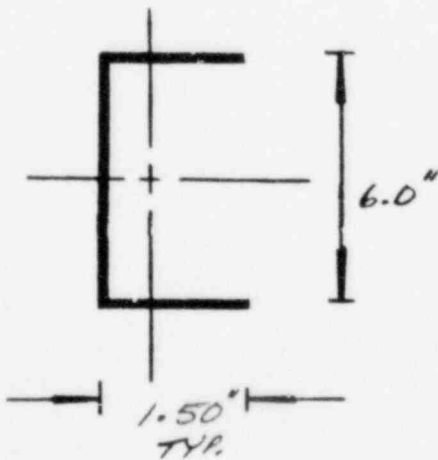

- \* ITEM 4 - SOLENOID  $\#$
- \*  $3/16$ " FILLET - 3 SIDES



# CALCULATION SHEET

JOB NO. 9645  
MISSISSIPPI POWER & LIGHT COMPANY

CALC. NO. Q1277, Q2277 REV. NO. A

PROJECT GRAND GULF NUCLEAR STATION

BY [Signature] DATE 3/5/82

SUBJECT SOLENDID MOUNTING PLATES

CKD James H. Callaghan DATE 3/14/82

SHEET NO. 75 OF 95

## FINAL WELDING REQUIREMENTS

LOADING CONDITION	ATTACHING DESIGN	LETTER	PROFILE (SHAPE)	VALUE GENERATED
PULLOUT	FCN-M-1150	D	CHANNEL	4.38 IN
SHEAR $X_2$	FCN-M-1149	D	PLATE	0.75 IN
SHEAR $X_3$	FCN-M-1149	D	PLATE	0.75 IN
TORSION	FCN-M-1142	B	ANGLE	C = 1.11 IN PMI = 1.95
BENDING $X_2$	FCN-M-1150	D	CHANNEL	0.77
BENDING $X_3$	FCN-M-1150	D	CHANNEL	0.77

NOTES: 1.) ABOVE GENERATED WELD PROPERTIES REFLECT THE CRITICAL VALUES FOR EACH ONE OF THE LOADING CONDITIONS, TAKEN FROM ALL POSSIBLE ATTACHING MEMBERS.

2.) THE APPLIED LOADS ARE THE RESULT OF THE CRITICAL  $F_{x1}$ ,  $F_{x2}$ , OR  $F_{x3}$  FOR ANY GIVEN STRUCTURE, COMBINED WITH THE CRITICAL  $M_{x1}$ ,  $M_{x2}$  OR  $M_{x3}$  VALUE, FOR ANY GIVEN STRUCTURE.



# CALCULATION SHEET

JOB NO. 9645 CALC. NO. Q1277, Q2277 REV. NO. A

PROJECT MISSISSIPPI POWER & LIGHT COMPANY BY [Signature] DATE 3/8/82

SUBJECT GRAND GULF NUCLEAR STATION CKD James H. Colyer DATE 3/10/82

SOLENOID MOUNTING PLATES SHEET NO. 76 OF 95

## FINAL WELDING REQUIREMENT (CONT.)

$$F_{x1} - F_{x2} - F_{x3} - \text{MAX. VALUE} - 0.050 \text{ K} \text{ (FCN-1143)}$$

$$M_{x1} - M_{x2} - M_{x3} - \text{MAX. VALUE} - 0.413 \text{ K-IN} \text{ (FCN-1138)}$$

∴ WELD SIZE

$$f_1 = \frac{0.05 \text{ K}}{0.75 \text{ IN}} + \frac{0.413 \text{ K-IN} (1.11)}{1.95} = 0.30 \text{ K/IN}$$

$$f_2 = \frac{0.05 \text{ K}}{0.75 \text{ IN}} + \frac{0.413 \text{ K-IN} (1.11)}{1.95} = 0.30 \text{ K/IN}$$

$$f_3 = \frac{0.05 \text{ K}}{4.38 \text{ IN}} + \frac{0.413 \text{ K-IN}}{0.77} + \frac{0.413 \text{ K-IN}}{0.77} = 1.08 \text{ K/IN}$$

$$f_R = \sqrt{(0.30)^2 + (0.30)^2 + (1.08)^2} = 1.16 \text{ K/IN}$$

$$w_R = \frac{1.16 \text{ K/IN}}{10.8 \text{ KSI}} = 0.11 \text{ IN (REQUIRED)}$$

$$\therefore 0.11 \text{ IN (REQ'D)} < 0.1875 \text{ IN (MINIMUM WELD SIZE)}$$

∴ ALL WELDS ON ALL ATTACHED STEEL ARE SATISFACTORY.



# CALCULATION SHEET

JOB NO. 9645      CALC. NO. Q1277, Q2277      REV. NO. A

PROJECT MISSISSIPPI POWER & LIGHT COMPANY      BY Regis M. H.      DATE 3/9/82

SUBJECT GRAND GULF NUCLEAR STATION      CKD James H. Callahan      DATE 3/16/82

SOLENOID MOUNTING PLATE      SHEET NO. 77 OF 95

FCN-M	NODE 38			NODE 41		
	F <sub>x</sub> (lbs)	F <sub>y</sub> (lbs)	F <sub>z</sub> (lbs)	F <sub>x</sub> (lbs)	F <sub>y</sub> (lbs)	F <sub>z</sub> (lbs)
1137	-4.84	1.27	-2.69	-2.16	0.72	0.09
1138	1.84	8.32	0.05	0.26	-0.14	0.56
1139	6.79	5.31	0.66	-2.55	0.32	2.67
1140	-7.97	-8.63	-1.95	-0.04	2.80	-2.88
1141	-5.62	2.08	-2.14	-1.25	2.38	1.02
1142	-3.92	2.43	-2.43	-0.78	-1.67	-0.19
1143	5.32	7.35	7.006	1.545	2.86	8.96
1144	1.15	6.27	0.17	2.37	0.07	0.24
1145	-1.92	-2.87	-0.71	0.25	-5.22	-3.39
1146	0.74	7.64	0.15	0.78	0.79	0.25
1147	0.49	2.70	0.64	-1.79	4.56	-0.20
1148	-3.47	9.38	-1.51	7.27	-2.18	2.33
1149	-1.91	13.30	-0.97	9.20	-12.47	1.78
1150	-1.05	7.17	0.22	1.69	2.31	0.20
1151	-4.77	1.87	-2.66	-1.01	-0.47	-0.01
1152	3.35	9.24	-0.30	-0.28	-1.34	1.11





# CALCULATION SHEET

JOB NO. 9645CALC. NO. Q1277, Q2777REV. NO. APROJECT MISSISSIPPI POWER & IGH COMPANYBY James W. McCall JrDATE 3/9/82SUBJECT GRAND GULF NUCLEAR STATIONCKD James W. McCall JrDATE 3/10/82SOLENOID MOUNTING PLATESHEET NO. 78 of 95

FCN-M	NODE 164			NODE 167		
	F <sub>x</sub> (lbs)	F <sub>y</sub> (lbs)	F <sub>z</sub> (lbs)	F <sub>x</sub> (lbs)	F <sub>y</sub> (lbs)	F <sub>z</sub> (lbs)
1137	-3.48	-4.88	-1.24	-1.14	-0.17	0.77
1138	-4.46	3.87	-1.38	-0.72	-0.43	-0.23
1139	-1.65	5.24	0.65	0.48	0.76	-0.91
1140	5.20	-8.51	0.39	-0.26	2.72	1.37
1141	-3.14	-2.41	-1.69	-1.60	1.02	-0.26
1142	-5.30	-2.02	-1.40	-1.62	-1.50	0.95
1143	4.33	5.86	7.31	0.83	1.00	8.50
1144	-4.25	3.74	-1.50	-0.82	-0.46	-1.98
1145	-0.95	-3.16	0.06	-0.46	-0.37	0.97
1146	-3.80	3.52	-1.49	-0.79	-0.33	-1.98
1147	-1.50	3.52	-1.86	-0.27	0.84	-1.65
1148	-4.70	5.75	-0.77	-2.16	-1.33	-3.12
1149	-7.33	7.95	-0.62	-3.04	2.83	-3.26
1150	-2.82	2.45	-1.45	-0.89	-0.31	-2.04
1151	-4.42	-3.36	-1.18	-1.42	-1.11	0.76
1152	-5.56	4.64	-0.99	-0.58	-0.92	-2.90



# CALCULATION SHEET

JOB NO. 9695CALC. NO. Q1277, Q2277REV. NO. APROJECT MISSISSIPPI POWER & LIGHT COMPANYBY W. J. M. J.DATE 2/9/82SUBJECT GRAND GULF NUCLEAR STATIONCKD James H. CallahanDATE 3/10/82SOLENOID MOUNTING PLATESHEET NO. 79 OF 95

FCN-M	NODE 49			NODE 50		
	F <sub>x</sub> (lbs)	F <sub>y</sub> (lbs)	F <sub>z</sub> (lbs)	F <sub>x</sub> (lbs)	F <sub>y</sub> (lbs)	F <sub>z</sub> (lbs)
1137	-4.26	-0.48	-1.83	0.59	-0.48	0.86
1138	0.84	1.83	-1.30	-1.81	1.83	0.33
1139	3.88	1.83	0.93	-2.91	1.83	0.04
1140	-5.54	-1.83	-0.86	4.57	-1.83	-0.11
1141	-4.72	0.48	-1.95	1.05	0.48	0.98
1142	-3.97	-0.48	-1.85	0.30	-0.48	0.88
1143	2.90	1.79	2.30	2.90	1.79	2.30
1144	0.50	1.83	-1.22	-1.47	1.83	0.25
1145	-2.15	-1.83	-0.82	1.18	-1.83	-0.15
1146	0.37	1.83	-1.22	-1.34	1.83	0.25
1147	0.88	1.83	-1.26	-1.85	1.83	0.29
1148	-0.06	1.83	-1.14	-0.91	1.83	0.17
1149	-0.12	1.83	-1.27	-0.85	1.83	0.30
1150	-0.53	1.83	-1.21	-0.44	1.83	-0.24
1151	-4.61	-0.48	-1.79	0.94	-0.48	0.82
1152	1.37	1.83	-1.29	-2.64	1.83	0.32



# CALCULATION SHEET

JOB NO. 9645CALC. NO. Q1277, Q2277REV. NO. APROJECT MISSISSIPPI POWER & LIGHT COMPANYBY Robert M. H. [Signature]DATE 3/9/82SUBJECT GRAND GULF NUCLEAR STATIONCKD James H. Callaghan [Signature]DATE 3/10/82SOLENOID MOUNTING PLATESHEET NO. 80 of 95

FCN-M	NODE 89			NODE 93		
	F <sub>x</sub> (lbs)	F <sub>y</sub> (lbs)	F <sub>z</sub> (lbs)	F <sub>x</sub> (lbs)	F <sub>y</sub> (lbs)	F <sub>z</sub> (lbs)
1137	-24.16	-6.05	-5.64	7.17	2.79	3.05
1138	15.18	18.63	1.99	5.31	-1.79	-1.54
1139	25.68	18.60	5.38	-0.23	-2.78	-1.63
1140	-36.85	-27.10	-7.93	-0.25	5.02	3.89
1141	-16.52	-1.11	-3.02	6.37	2.21	1.63
1142	-15.83	-1.65	-4.94	5.92	1.15	2.46
1143	21.15	18.38	5.61	2.11	3.03	4.06
1144	14.04	17.90	2.20	5.63	-1.64	-1.81
1145	-17.44	-12.69	-4.42	0.01	1.30	0.91
1146	13.17	16.93	2.18	5.28	-1.45	-1.79
1147	13.45	12.64	3.16	0.48	-1.01	-2.71
1148	15.58	18.70	-1.03	6.10	-2.16	1.26
1149	17.23	22.06	0.89	8.52	-2.78	-0.55
1150	8.94	14.50	2.38	6.06	-0.75	-1.95
1151	-19.85	-3.83	-5.21	6.52	1.91	2.77
1152	18.94	21.43	1.25	5.06	-2.45	-0.72



# CALCULATION SHEET

JOB NO. 9645CALC. NO. Q1277, Q2277REV. NO. APROJECT MISSISSIPPI POWER & LIGHT COMPANYBY Robert MitchellDATE 3/9/82SUBJECT GRAND GULF NUCLEAR STATIONCKD James H. CallaghanDATE 3/10/82SOLENOID MOUNTING PLATESHEET NO. 81 OF 95

FCN-M	NODE 117			NODE 121		
	F <sub>x</sub> (lbs)	F <sub>y</sub> (lbs)	F <sub>z</sub> (lbs)	F <sub>x</sub> (lbs)	F <sub>y</sub> (lbs)	F <sub>z</sub> (lbs)
1137	2.51	0.94	3.16	8.98	0.86	-2.02
1138	-13.85	-9.35	-4.06	-8.09	-1.99	2.15
1139	-12.56	-8.24	-3.75	-11.44	-2.07	1.46
1140	19.31	13.16	6.19	16.34	3.42	-3.60
1141	-0.36	-0.44	0.50	5.01	0.80	-0.56
1142	-0.84	-1.28	2.59	5.25	-0.32	-1.56
1143	13.23	9.17	5.94	10.03	2.55	4.39
1144	-13.40	-8.58	-4.31	-7.72	-1.88	2.47
1145	7.95	4.80	3.24	8.02	1.09	-1.19
1146	-12.57	-8.28	-4.29	-7.34	-1.70	2.44
1147	-8.27	-5.38	-5.25	-7.13	-0.75	3.34
1148	-14.14	-9.06	-1.09	-9.00	-1.98	-0.55
1149	-17.22	-11.16	-2.94	-9.98	-2.61	1.15
1150	-10.82	-6.91	-4.43	-5.64	-1.33	2.55
1151	0.75	-0.15	2.97	7.07	0.62	-1.99
1152	-15.89	-11.07	-3.25	-9.56	-2.40	1.26



# CALCULATION SHEET

JOB NO. 9695CALC. NO. Q1277, Q2277REV. NO. APROJECT MISSISSIPPI POWER & IGH COMPANYBY James H. ColledgeDATE 3/9/82SUBJECT GRAND GULF NUCLEAR STATIONCKD James H. ColledgeDATE 3/10/82SOLENOID MOUNTING PLATESHEET NO. 82 of 95

FCN-M	NODE 131			NODE 135		
	F <sub>x</sub> (lbs)	F <sub>y</sub> (lbs)	F <sub>z</sub> (lbs)	F <sub>x</sub> (lbs)	F <sub>y</sub> (lbs)	F <sub>z</sub> (lbs)
1137	-7.14	-3.67	-2.75	-3.29	-0.26	1.13
1138	-4.21	11.53	1.80	12.49	0.94	-1.15
1139	0.12	11.58	3.01	12.01	0.69	-0.15
1140	2.07	-16.79	-4.33	-18.67	-0.62	1.61
1141	-5.46	-0.58	-1.18	-1.49	-0.62	-0.45
1142	-7.15	-0.98	-2.45	-0.41	-0.09	-0.80
1143	2.61	11.60	5.03	12.47	1.10	3.63
1144	-4.04	11.15	1.92	12.02	0.94	-1.28
1145	-1.67	-7.92	-2.83	-7.32	-0.76	0.09
1146	-3.63	10.55	1.90	11.16	0.94	-1.26
1147	-0.60	7.93	1.43	6.57	0.89	-1.83
1148	-3.09	11.56	0.17	12.09	0.87	0.62
1149	-4.74	13.59	0.96	15.12	1.05	0.03
1150	-3.23	9.04	1.98	9.39	0.96	-1.34
1151	-7.18	-2.30	-2.67	-1.81	0.18	1.02
1152	-4.99	13.14	1.26	14.54	0.94	-0.51



# CALCULATION SHEET

JOB NO. 9695CALC. NO. Q1277, Q2277REV. NO. APROJECT MISSISSIPPI POWER & LIGHT COMPANYBY John Mott DATE 2/19/82SUBJECT GRAND GULF NUCLEAR STATIONCKD James H. Callaghan DATE 3/10/82SOLENOID MOUNTING PLATESHEET NO. 83 of 95

FCN-M	NODE 145			NODE 149		
	F <sub>x</sub> (lbs)	F <sub>y</sub> (lbs)	F <sub>z</sub> (lbs)	F <sub>x</sub> (lbs)	F <sub>y</sub> (lbs)	F <sub>z</sub> (lbs)
1137	2.93	0.59	-0.22	1.99	1.37	0.38
1138	-19.10	-6.01	-2.89	9.37	-0.96	0.79
1139	-17.65	-5.32	-0.74	6.98	-1.44	-0.67
1140	29.07	9.15	1.60	-13.92	2.75	-0.33
1141	0.56	0.02	-1.40	0.88	1.40	0.67
1142	-2.44	-1.23	-0.35	4.50	0.66	0.55
1143	19.12	6.31	4.71	9.25	1.89	3.31
1144	-18.22	-5.72	-2.99	8.79	-0.87	0.90
1145	9.49	2.62	1.08	-1.95	0.55	0.21
1146	-16.85	-5.26	-2.99	7.87	-0.73	-0.90
1147	-10.56	-3.11	-3.32	3.14	-0.20	1.26
1148	-18.26	-5.82	-1.99	7.80	-1.11	-0.25
1149	-22.88	-7.42	-2.53	11.04	-1.72	0.09
1150	-13.53	-4.17	-2.97	5.91	-0.33	0.88
1151	0.19	-0.34	-0.09	3.28	1.01	0.28
1152	-22.74	-7.23	-2.54	11.73	-1.36	0.33



# CALCULATION SHEET

JOB NO. 9695CALC. NO. Q1277, Q2277REV. NO. APROJECT MISSISSIPPI POWER & LIGHT COMPANYBY James H. CallaghanDATE 3/19/82SUBJECT GRAND GULF NUCLEAR STATIONCKD James H. CallaghanDATE 3/10/82SOLENOID MOUNTING PLATESHEET NO. 84 OF 95

FCN-M	NODE 72			NODE 74		
	F <sub>x</sub> (lbs)	F <sub>y</sub> (lbs)	F <sub>z</sub> (lbs)	F <sub>x</sub> (lbs)	F <sub>y</sub> (lbs)	F <sub>z</sub> (lbs)
1137	18.52	-13.81	-0.90	40.07	35.52	10.94
1138	-20.10	35.54	-3.60	-19.81	-107.21	4.81
1139	-29.03	37.88	-0.43	-38.78	-107.90	-8.53
1140	41.71	-60.43	0.69	55.29	162.21	11.36
1141	12.86	-8.19	-1.87	28.32	9.62	9.22
1142	10.72	-2.47	-0.73	26.31	7.51	9.98
1143	27.82	41.72	31.82	33.61	109.62	30.32
1144	-19.21	33.47	-3.55	-18.41	-102.97	4.70
1145	17.47	-21.09	1.07	25.44	70.29	6.20
1146	-17.85	30.91	-3.52	-17.10	-96.88	4.68
1147	-14.82	21.19	-3.77	-18.47	-70.91	3.80
1148	-14.43	33.47	-3.00	-18.98	-107.80	8.03
1149	-22.70	41.19	-3.44	-20.48	-128.82	6.41
1150	-12.94	23.73	-3.43	-10.24	-51.13	4.26
1151	14.88	-8.30	-0.34	32.36	21.45	9.68
1152	-23.59	43.09	-3.18	-24.93	-124.58	5.09



# CALCULATION SHEET

JOB NO. 9695CALC. NO. Q1277, Q2277REV. NO. APROJECT MISSISSIPPI POWER & LIGHT COMPANYBY [Signature] DATE 3/9/82SUBJECT GRAND GULF NUCLEAR STATIONCKD [Signature] DATE 3/10/82SOLENOID MOUNTING PLATESHEET NO. 85 OF 95

FCN-M	NODE 100			Fx (lbs)	Fy (lbs)	Fz (lbs)
	Fx (lbs)	Fy (lbs)	Fz (lbs)			
1137	-6.33	-8.25	-0.58			
1138	57.53	27.76	5.41			
1139	51.19	27.96	1.92			
1140	-81.92	-45.26	-4.27			
1141	4.04	-4.28	1.80			
1142	9.13	0.26	-0.21			
1143	57.58	32.56	32.92			
1144	56.07	26.15	5.50			
1145	-29.86	-15.29	-1.79			
1146	52.33	24.15	5.50			
1147	34.00	16.03	6.35			
1148	57.38	26.28	2.70			
1149	70.79	32.58	4.39			
1150	43.98	18.82	5.58			
1151	2.13	-4.08	-0.62			
1152	65.54	33.98	4.83			





# CALCULATION SHEET

JOB NO. 9645  
 MISSISSIPPI POWER & LIGHT COMPANY  
 PROJECT GRAND GULF NUCLEAR STATION  
 SUBJECT SOLENOID MOUNTING PLATE

CALC. NO. Q1277, Q2277 REV. NO. A  
 BY James D. Callaghan DATE 3/10/02  
 CKD James D. Callaghan DATE 3/10/02  
 SHEET NO. 06 of 95

Max Accel. in X direction = .07258  
 Max Accel. in Y direction = .09719  
 Max Accel. in Z direction = .72893

} FROM DYNRE 4 ANALYSIS

Forces Due To Acceleration = accel x mass

For Junction Box.  
 (NODES 30, 41, 164, 167)

$F_x = 9.5 \times .07258 = .690$   
 $F_y = 9.5 \times .09719 = .923$   
 $F_z = 9.5 \times .72893 = 6.925$

For Solenoid  
 (NODES 49, 50)

$F_x = 3.0 \times .07258 = .218$   
 $F_y = 3.0 \times .09719 = .292$   
 $F_z = 3.0 \times .72893 = 2.187$

For Limit Switches  
 (NODES 89, 93, 117, 121, 131, 135, 145, 149)

$F_x = 4.5 \times .07258 = .327$   
 $F_y = 4.5 \times .09719 = .437$   
 $F_z = 4.5 \times .72893 = 3.280$

For Solenoid Plate  
 (NODES 72, 74, 100)


$F_x = 41.14 \times .07258 = 2.986$   
 $F_y = 41.14 \times .09719 = 3.998$   
 $F_z = 41.14 \times .72893 = 29.988$

NOTES: For FCN-M-1193 the forces calculated above shall be added to forces from the equilibrium check taken from the static run

Forces for all other FCN'S taken from equilibrium check from the static analysis



# CALCULATION SHEET

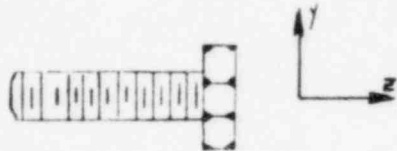JOB NO. 9395CALC. NO. Q1277, Q2277REV. NO. APROJECT MISSISSIPPI POWER & LIGHT COMPANYBY James M. KellyDATE 2/9/82SUBJECT GRAND GULF NUCLEAR STATIONCKD James M. KellyDATE 3/10/82SOLENOID MOUNTING PLATESHEET NO. 87 OF 95

1/4" Hex Head Bolts for Junction Box. (NODES 38, 41, 164, 167)

$$F_{z \max} = 8.96 \text{ lbs} < 270 \text{ lbs}^*$$

$$\sqrt{F_{x \max}^2 + F_{y \max}^2} = \sqrt{(9.2)^2 + (13.3)^2} = 16.17 \text{ lbs} < 380 \text{ lbs}^*$$

\* Allowable Loads from MARK'S HANDBOOK P. B-30, TABLE 32

1/2" Bolts Connecting Solenoid R to Actuator (NODES 72, 74, 100)

$$F_{z \max} = 32.42 \text{ lbs} < 1,260 \text{ lbs}^*$$

$$\sqrt{F_{x \max}^2 + F_{y \max}^2} = \sqrt{(70.79)^2 + (162.21)^2} = 176.98 \text{ lbs} < 1,470 \text{ lbs}^*$$

\* Allowable Loads from MARK'S HANDBOOK P. B-30, TABLE 32



# CALCULATION SHEET

JOB NO. 9645CALC NO. Q1277, Q2377REV. NO. APROJECT MISSISSIPPI POWER & LIGHT COMPANYBY David M. WithDATE 3/9/82SUBJECT GRAND GULF NUCLEAR STATIONCKD James H. CallahanDATE 3/10/82SOLENOID MOUNTING PLATESHEET NO. 88 OF 95

$\frac{1}{8}$ " MACHINE SCREWS, for Limit Switches + Solenoid (NODES 89, 93, 117, 121, 131, 135, 145, 149, 49, 50)

Max Tensile Stress:

$$\tau \sigma_T = \frac{F_{T \max}}{\text{Stress Area}^*}$$

$$\sigma_T = \frac{7.93 \text{ lbs}}{.0079 \text{ in}^2} = 1,004 \text{ PSI} = 1.004 \text{ KSI} < 7.5 \text{ KSI}^{**}$$

Max. Shear Stress:

$$\sigma_v = \frac{\sqrt{F_{x \max}^2 + F_{y \max}^2}}{\text{Basic min minor dia.}^*}$$

$$\sigma_v = \frac{\sqrt{(36.85)^2 + (27.10)^2}}{.0067 \text{ in}^2} = 6,827 \text{ PSI} = 6.827 \text{ KSI} < 7.5 \text{ KSI}^{**}$$

\* Stress Area + Basic min. minor dia. From MARKS HANDBOOK P.8-10, Table 1.

\*\* Allowable Stress Taken from MARK'S HANDBOOK P.8-30, TABLE 32



# CALCULATION SHEET

JOB NO. 9645CALC. NO. Q1277, Q2277REV. NO. APROJECT MISSISSIPPI POWER & LIGHT COMPANYBY Stephen A. DescoteauxDATE 3/10/82SUBJECT GRAND GULF NUCLEAR STATIONCKD James H. ColbyDATE 3/14/82SOLENOID MOUNTING PLATESHEET NO. 89 OF 95

## CHECK A307 1/2" $\phi$ STRUCTURAL BOLTS

THE MAXIMUM FORCE IN ANY DIRECTION FOR ALL BEAM ELEMENTS WAS FOUND TO BE 50#; THIS ENCOMPASSES THE LOADING AT THE BOLTED CONNECTIONS FOR ALL (16) SOLENOID PLATE PROBLEMS

ASSUME 50# IN (3) DIRECTIONS AND APPLY THE SUM TO (1) BOLT

$\therefore$  TOTAL BOLT LOAD = 150#

- ASSUMING THIS LOAD IS A SHEAR FORCE OVER THE FULL NOMINAL AREA,

$$f_v, \text{BOLT} = \frac{150}{\frac{\pi (.5)^2}{4}} = 764 \text{ PSI}$$

$F_v$  FOR A307 BOLTS = 10.0 KSI (REF. SEC. 1.5.2.1 OF AISC MANUAL)

SINCE .764 KSI < 10.0 KSI, A307 BOLTS ARE O.K.

## CHECK BASE PLATES AND BOLTS

ANCHOR REACTIONS ARE NEGLIGIBLE AT THE BASE PLATES OF THE (2) SOLENOID PLATE STRUCTURES THAT CONTAIN CONNECTIONS TO FLOOR





# CALCULATION SHEET

JOB NO. 9645CALC. NO. Q1277, Q2277REV. NO. APROJECT MISSISSIPPI POWER & LIGHT COMPANYBY [Signature]DATE 3/9/82SUBJECT GRAND GULF NUCLEAR STATIONCKD [Signature]DATE 3/10/82SOLENOID MOUNTING PLATESHEET NO. 90 OF 95

FCN-M-	ACTUATOR	MAX. Δ (in)	FREQ.	MAX. BEAM* STRESS (PSI)	MAX. QUAD. R** STRESS (PSI)
1137	Q1277F001A	±0.0042	34.60	100.33	946.22
1138	Q1277F001B	±0.0076	35.20	267.16	2,264.63
1139	Q2277F001B	±0.0040	35.65	245.55	676.19
1140	Q2277F001A	±0.0067	34.25	206.97	917.22
1141	Q2277F035B	±0.0047	34.21	150.55	1,262.11
1142	Q1277F035B	±0.0037	41.38	170.31	913.55
1143	Q2277F002B	±0.0160	29.70	696.99	5,056.70
1144	Q1277F002B	±0.0077	34.68	365.32	2,312.77
1145	Q2277F002A	±0.0033	38.40	297.77	594.39
1146	Q1277F002A	±0.0076	35.19	253.65	2,276.38
1147	Q1277F002B	±0.0081	33.62	654.70	2,357.63
1148	Q2277F002B	±0.0070	33.09	382.76	1,991.48
1149	Q1277F002A	±0.0077	35.07	210.69	2,331.97
1150	Q2277F003A	±0.0074	35.37	318.83	2,181.18
1151	Q1277F035A	±0.0039	42.28	144.51	824.88
1152	Q2277F035A	±0.0066	38.36	371.86	2,108.14

\* Beam stresses negligible

\*\* Max Quad R stress 5,057 ksi &lt; 10 ksi = .4 Fy



# CALCULATION SHEET

JOB NO. 9645

CALC. NO. Q1Z77, Q2Z77

REV. NO. A

PROJECT MISSISSIPPI POWER & LIGHT COMPANY

BY Stephen A. Descoteaux

DATE 3/10/82

SUBJECT GRAND GULF NUCLEAR STATION

CKD [Signature]

DATE 3/10/82

SOLENOID MOUNTING PLATE


SHEET NO. 91 OF 95

## ANALYSIS RESULTS


- 1) MAXIMUM DISPLACEMENT : .016"
- 2) MAXIMUM BEAM STRESS : 697 PSI  
(COMBINED AXIAL AND BENDING OR COMBINED SHEAR)
- 3) MAXIMUM QUADRILATERAL PLATE STRESS : 5057 PSI  
(CONSERVATIVE)
- 4) LOWEST NATURAL FREQUENCY OF (15) STATIC EQUIVALENT  
ANALYSES: 33.09 CPS
- 5) MINIMUM REQUIRED WELD = .11" THICK
- 6) ALL BOLT AND SCREW CONNECTIONS ARE ADEQUATE




# CALCULATION SHEET

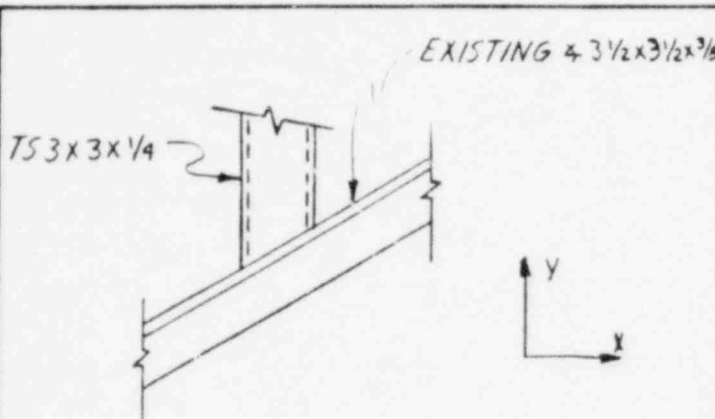JOB NO. 9645CALC. NO. Q1Z77, Q2Z77REV. NO. APROJECT MISSISSIPPI POWER & LIGHT COMPANYBY Roger MitthDATE 3/9/82SUBJECT GRAND GULF NUCLEAR STATIONCKD Jamond CollyerDATE 3/10/82SOLENOID MOUNTING PLATESHEET NO. 92 OF 95Q1Z77F035A (FCN-M-1151)


$F_x = \pm 4.66$ lbs	$M_x = \pm 53.72$ in.-lbs
$F_y = \pm 0.17$ lbs	$M_y = \pm 10.11$ in.-lbs
$F_z = \pm 3.66$ lbs	$M_z = \pm 61.76$ in.-lbs

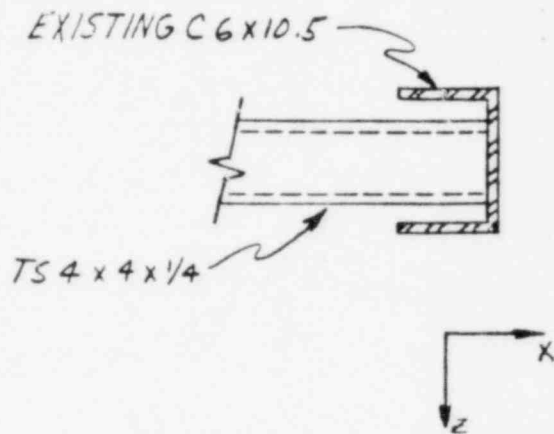Q1Z77F003A (FCN-M-1149)

$F_x = \pm 12.67$ lbs	$M_x = \pm 169.62$ in.-lbs
$F_y = \pm 21.90$ lbs	$M_y = \pm 174.41$ in.-lbs
$F_z = \pm 3.34$ lbs	$M_z = \pm 358.37$ in.-lbs

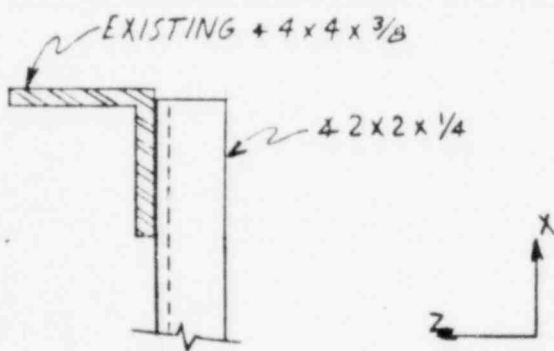Q2Z77F002A (FCN-M-1145)

$F_x = \pm 2.41$ lbs	$M_x = \pm 7.02$ in.-lbs
$F_y = \pm 8.08$ lbs	$M_y = \pm 1.93$ in.-lbs
$F_z = \pm 5.64$ lbs	$M_z = \pm 0.22$ in.-lbs

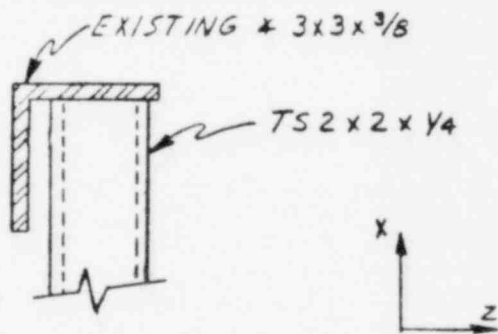Q1Z77F002B (FCN-M-1147)

$F_x = \pm 11.27$ lbs	$M_x = \pm 44.52$ in.-lbs
$F_y = \pm 11.67$ lbs	$M_y = \pm 98.98$ in.-lbs
$F_z = \pm 5.60$ lbs	$M_z = \pm 67.47$ in.-lbs





# CALCULATION SHEET

JOB NO. 9645

CALC. NO. Q1Z77, Q2Z77 REV. NO. A

PROJECT MISSISSIPPI POWER & LIGHT COMPANY


BY James H. Kelly DATE 3/9/82

SUBJECT GRAND GULF NUCLEAR STATION

CKD James H. Kelly DATE 3/10/82


SOLENOID MOUNTING PLATE

SHEET NO. 93 OF 95

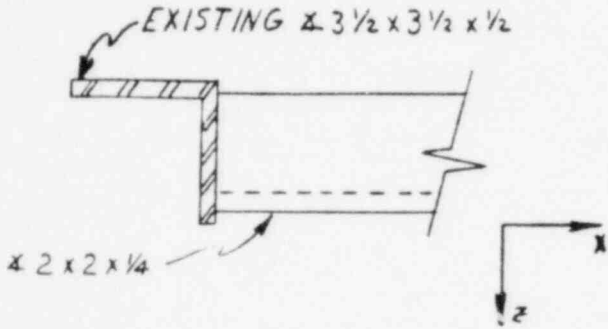


Q2Z77F035A (FCN-M-1152)

$F_x = \pm 5.02$ lbs	$M_x = \pm 0.77$ in-lbs
$F_y = \pm 2.08$ lbs	$M_y = \pm 70.58$ in-lbs
$F_z = \pm 5.25$ lbs	$M_z = \pm 20.00$ in-lbs

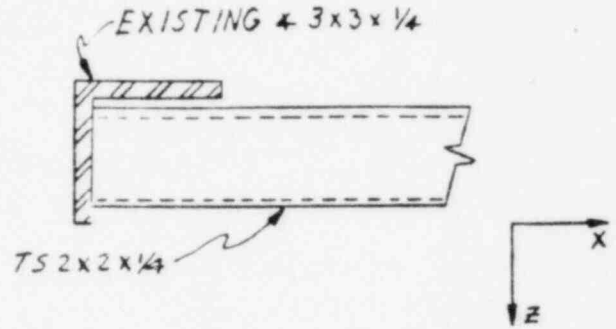


Q2Z77F001B (FCN-M-1139)

$F_x = \pm 3.27$ lbs	$M_x = \pm 17.81$ in-lbs
$F_y = \pm 5.21$ lbs	$M_y = \pm 74.06$ in-lbs
$F_z = \pm 4.81$ lbs	$M_z = \pm 59.13$ in-lbs

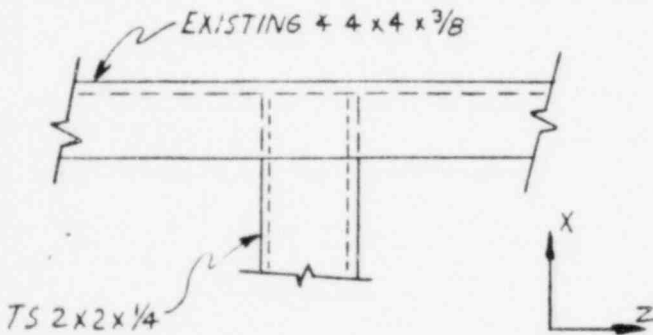

Q2Z77F035B (FCN-M-1141)

$F_x = \pm 2.97$ lbs	$M_x = \pm 1.65$ in-lbs
$F_y = \pm 9.27$ lbs	$M_y = \pm 1.72$ in-lbs
$F_z = \pm 0.62$ lbs	$M_z = \pm 63.15$ in-lbs

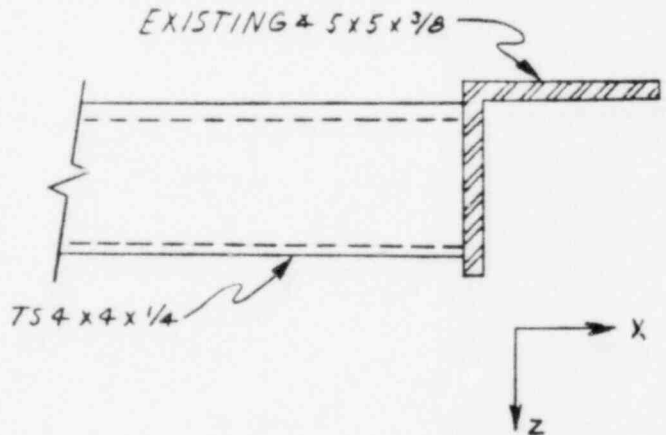


Q2Z77F003A (FCN-M-1150)


$F_x = \pm 6.85$ lbs	$M_x = \pm 109.21$ in-lbs
$F_y = \pm 13.86$ lbs	$M_y = \pm 80.35$ in-lbs
$F_z = \pm 7.44$ lbs	$M_z = \pm 6.78$ in-lbs




# CALCULATION SHEET

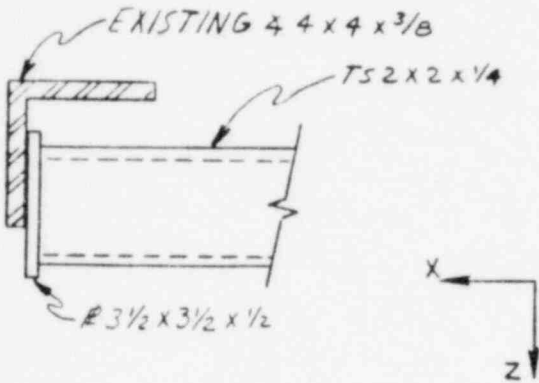JOB NO. 9645CALC. NO. Q1277, Q2277 REV. NO. APROJECT MISSISSIPPI POWER & LIGHT COMPANYBY Peter Mitt DATE 3/9/82SUBJECT GRAND GULF NUCLEAR STATIONCKD James G. Callahan DATE 3/10/82SOLENOID MOUNTING PLATESHEET NO. 94 OF 95Q1277F003B (FCN-M-1144)


$$\begin{aligned}
 F_x &= \pm 5.90 \text{ lbs} & M_x &= \pm 22.46 \text{ in-lbs} \\
 F_y &= \pm 4.16 \text{ lbs} & M_y &= \pm 98.65 \text{ in-lbs} \\
 F_z &= \pm 5.91 \text{ lbs} & M_z &= \pm 45.91 \text{ in-lbs}
 \end{aligned}$$

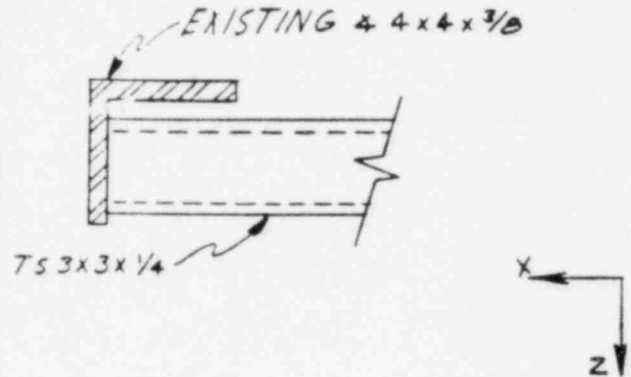Q1277F002A (FCN-M-1146)

$$\begin{aligned}
 F_x &= \pm 4.94 \text{ lbs} & M_x &= \pm 71.30 \text{ in-lbs} \\
 F_y &= \pm 5.31 \text{ lbs} & M_y &= \pm 73.83 \text{ in-lbs} \\
 F_z &= \pm 5.78 \text{ lbs} & M_z &= \pm 24.87 \text{ in-lbs}
 \end{aligned}$$

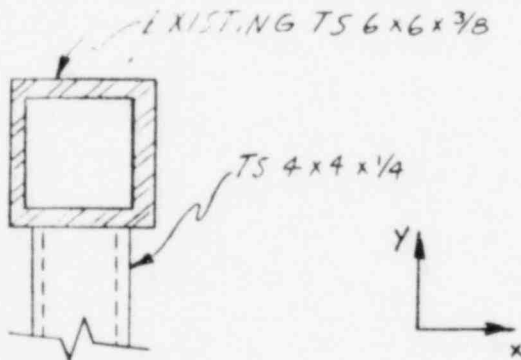Q1277F001A (FCN-M-1137)

$$\begin{aligned}
 F_x &= \pm 7.08 \text{ lbs} & M_x &= \pm 277.69 \text{ in-lbs} \\
 F_y &= \pm 25.54 \text{ lbs} & M_y &= \pm 30.91 \text{ in-lbs} \\
 F_z &= \pm 11.09 \text{ lbs} & M_z &= \pm 94.76 \text{ in-lbs}
 \end{aligned}$$

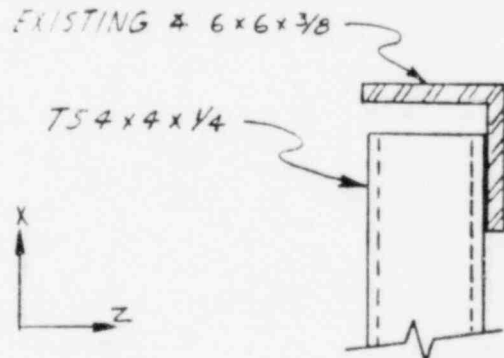Q2277F001A (FCN-M-1140)

$$\begin{aligned}
 F_x &= \pm 14.00 \text{ lbs} & M_x &= \pm 156.39 \text{ in-lbs} \\
 F_y &= \pm 25.94 \text{ lbs} & M_y &= \pm 254.44 \text{ in-lbs} \\
 F_z &= \pm 6.70 \text{ lbs} & M_z &= \pm 154.10 \text{ in-lbs}
 \end{aligned}$$



# CALCULATION SHEET

JOB NO. 9645

CALC. NO. Q1277, Q2277 REV. NO. A

PROJECT MISSISSIPPI RIVER


BY James N. Cully DATE 3/9/82

SUBJECT GRAND GULF NUCLEAR STATION

CKD James N. Cully DATE 3/10/82


SOLENOID MOUNTING PLATE

SHEET NO. 95 OF 95

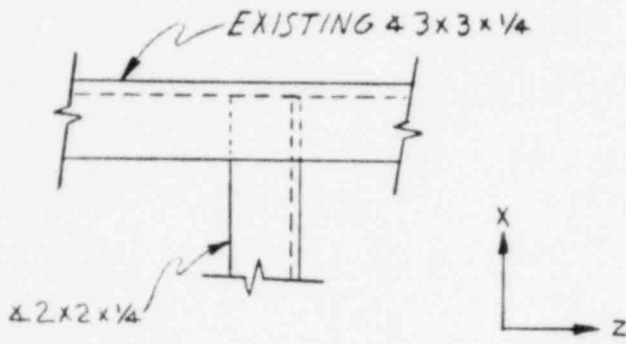

Q1277F035B (FCN-M-1142)

$F_x = \pm 3.18$ lbs	$M_x = \pm 1.10$ in-lbs
$F_y = \pm 6.92$ lbs	$M_y = \pm 2.55$ in-lbs
$F_z = \pm 0.13$ lbs	$M_z = \pm 17.83$ in-lbs

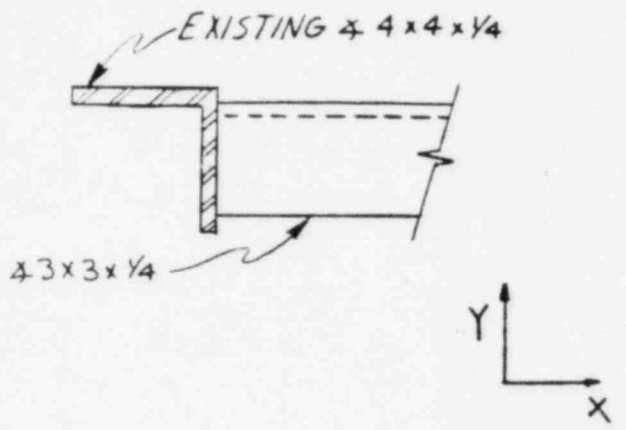

Q2277F003B (FCN-M-1143)

$F_x = \pm 5.165$	$M_x = \pm 29.11$ in-lbs
$F_y = \pm 41.165$	$M_y = \pm 28.11$ in-lbs
$F_z = \pm 6.165$	$M_z = \pm 186.11$ in-lbs